


SEE 9-00-096-B

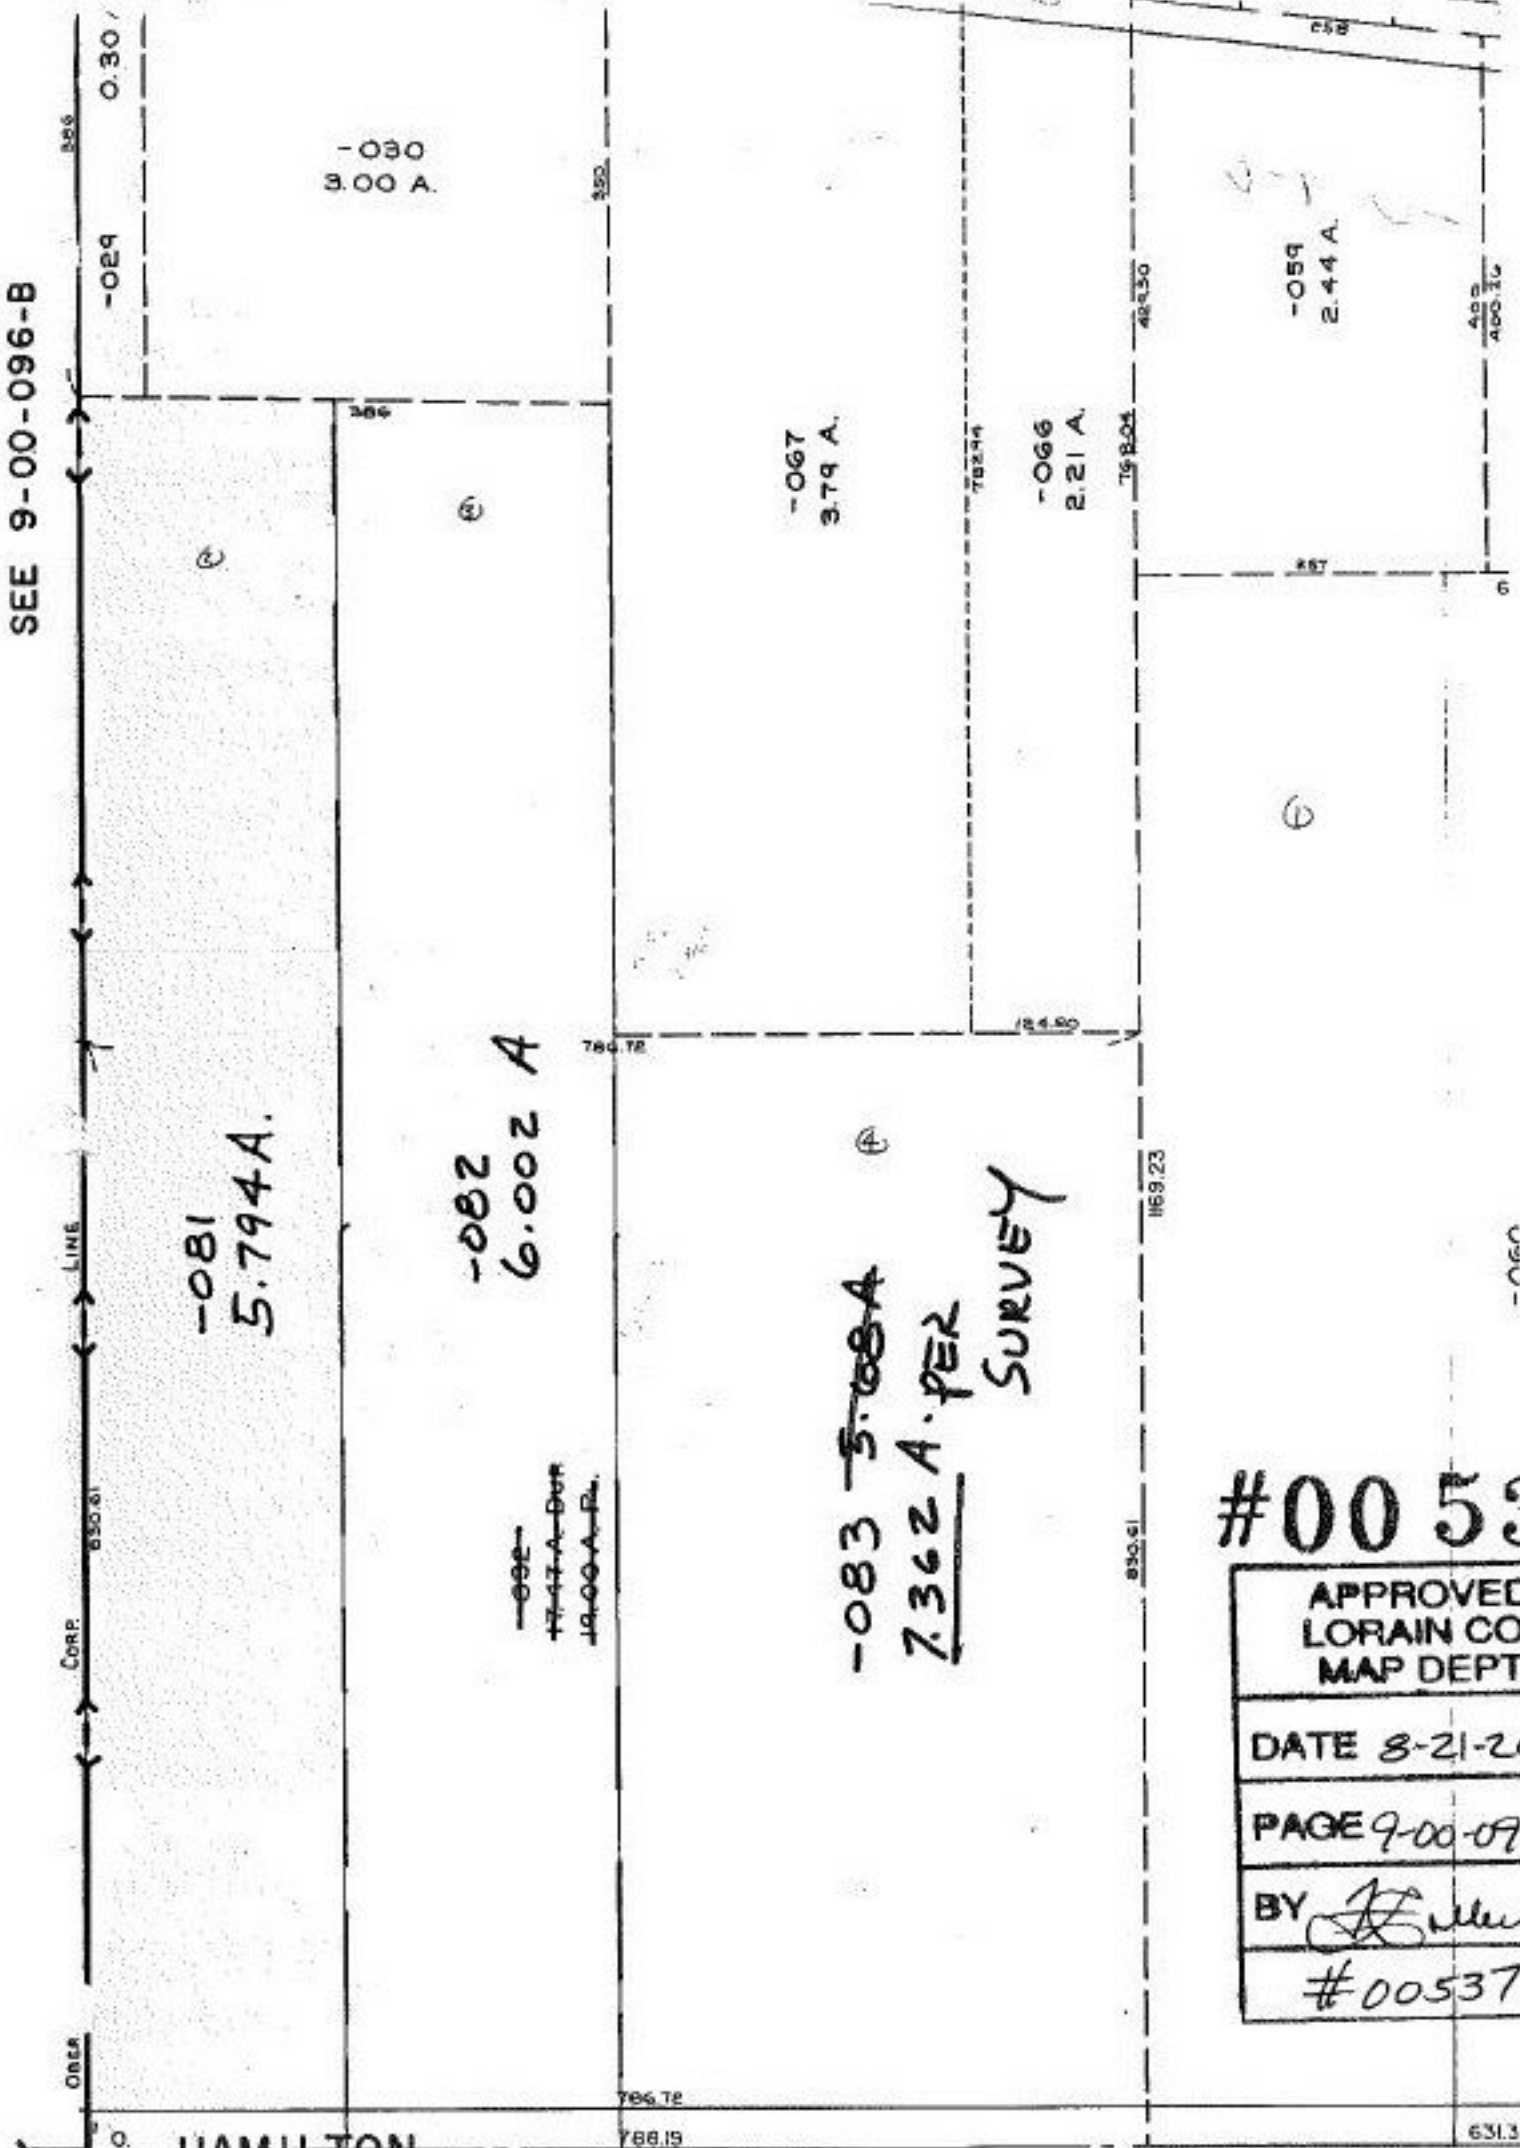

-081
5.794 A.

-082
6.002 A

-083 ~~5.088 A~~
7.362 A. PER
SURVEY

#00537

APPROVED LORAIN CO. MAP DEPT
DATE 8-21-2000
PAGE 9-00-097 A
BY <i>[Signature]</i>
#00537

HAMILTON

SEE 9-G