

FASTER

PARENT PARCEL: 05-00-061-104-020

CHILD PARCEL: 05-00-061-104-035, -036


STARTING POINT: CENTERLINE OF OBERLIN AVE & COOPER FOSTER PARK RD

NO. 00542




OBERLIN AVE.

COOPER FOSTER PARK RD.¹⁰

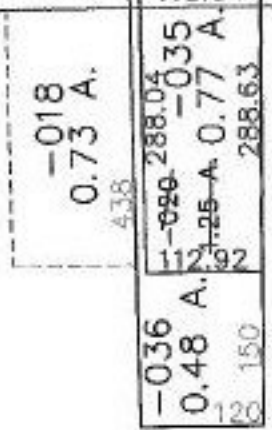

104

PT. -016
PT. 71.53 A.

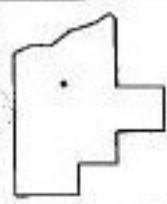

SPLITS/DEEDS PROCESSED
LORAIN COUNTY TAX MAP DEPARTMENT
226 MIDDLE AVE. ELYRIA, OHIO

SURVEYED BY: PATRICK A. MCGANNON
CLOSURE: 0.04 : 10.000
MAP PAGE(S): 5-00-061-B
APPROVED BY: JAH DATE: 8-25-00
SCALE: 1" = 200' PRIOR INSTRUMENT: DV 1419/873