
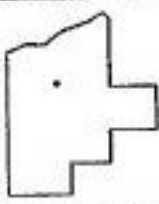


CASTER

NO. 00547

PARENT PARCEL: 20-20-012-000-004, 20-20-013-000-007, -008
CHILD PARCEL: 20-20-012-000-005 THRU -011 20-20-013-000-015 THRU -021
STARTING POINT: CENTERLINE OF BURSLEY RD & O.L. 13

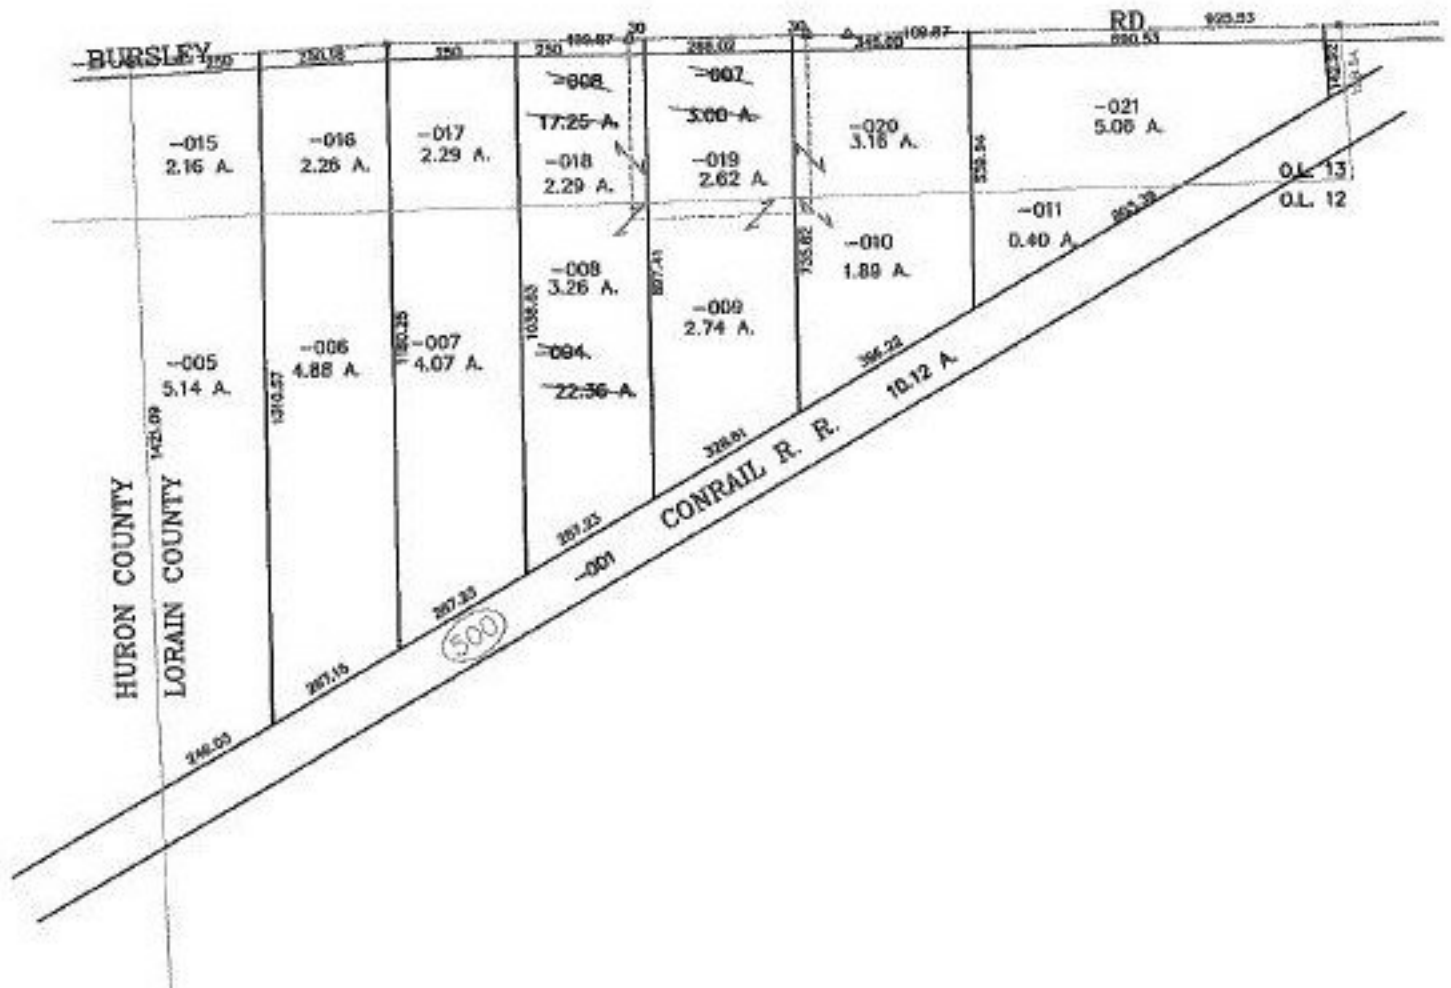

SPLITS/DEEDS PROCESSED
LORAIN COUNTY TAX MAP DEPARTMENT
226 MIDDLE AVE. ELYRIA, OHIO

SURVEYED BY: THOMAS A. SIMON
CLOSURE: 0.13 : 10,000
MAP PAGE(S): 20-B
APPROVED BY: JAH DATE: 8-28-00
SCALE: 1" = 400' PRIOR INSTRUMENT: OR1029/825