


MASTER

PARENT PARCEL: 09-00-012-000-036

CHILD PARCEL: 09-00-012-000-037 & -038

STARTING POINT: MON. BOX, CL. OF RUSSIA RD. & CL. OF QUARRY RD.

NO. 00548

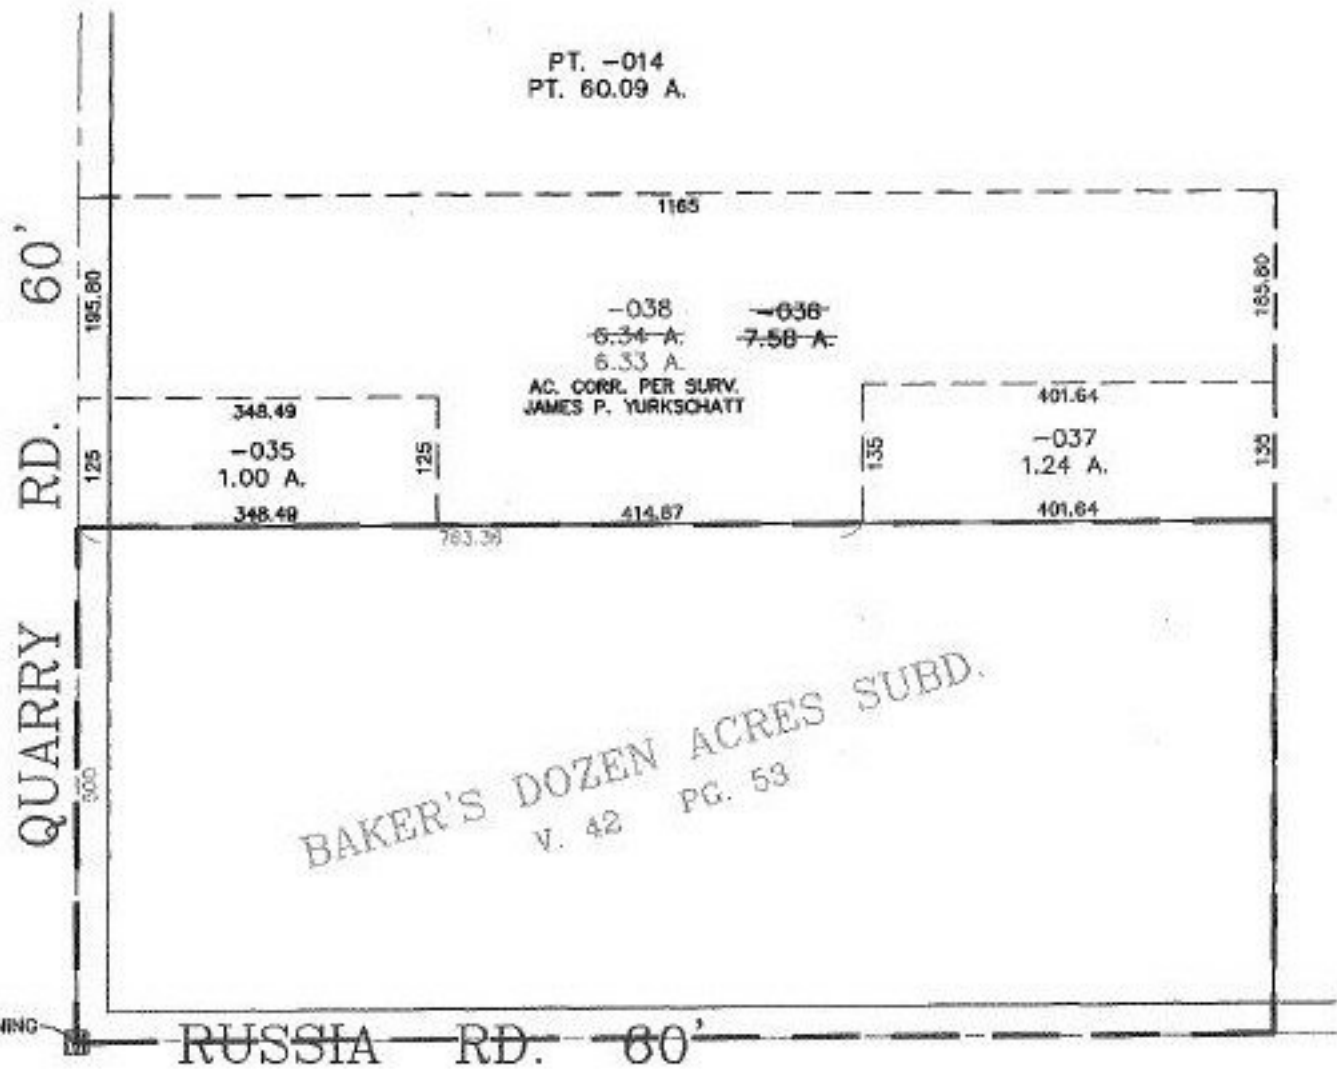

SPLITS/DEEDS PROCESSED
 LORAIN COUNTY TAX MAP DEPARTMENT
 226 MIDDLE AVE. ELYRIA, OHIO

SURVEYED BY: JAMES P. YURKSCHATT
 CLOSURE: 0.00 : 10.000
 MAP PAGE(S): 9-00-012-A
 APPROVED BY: T. SPILLMAN DATE: 08/28/00
 SCALE: 1" = 200' PRIOR INSTRUMENT: DV 1415/724