

PASTER

PARENT PARCEL: 14-00-122-000-001


CHILD PARCEL: 14-00-122-000-012, 013

STARTING POINT: CENTERLINES OF WHITNEY & WEST RD.

NO. 00557



WHITNEY RD.

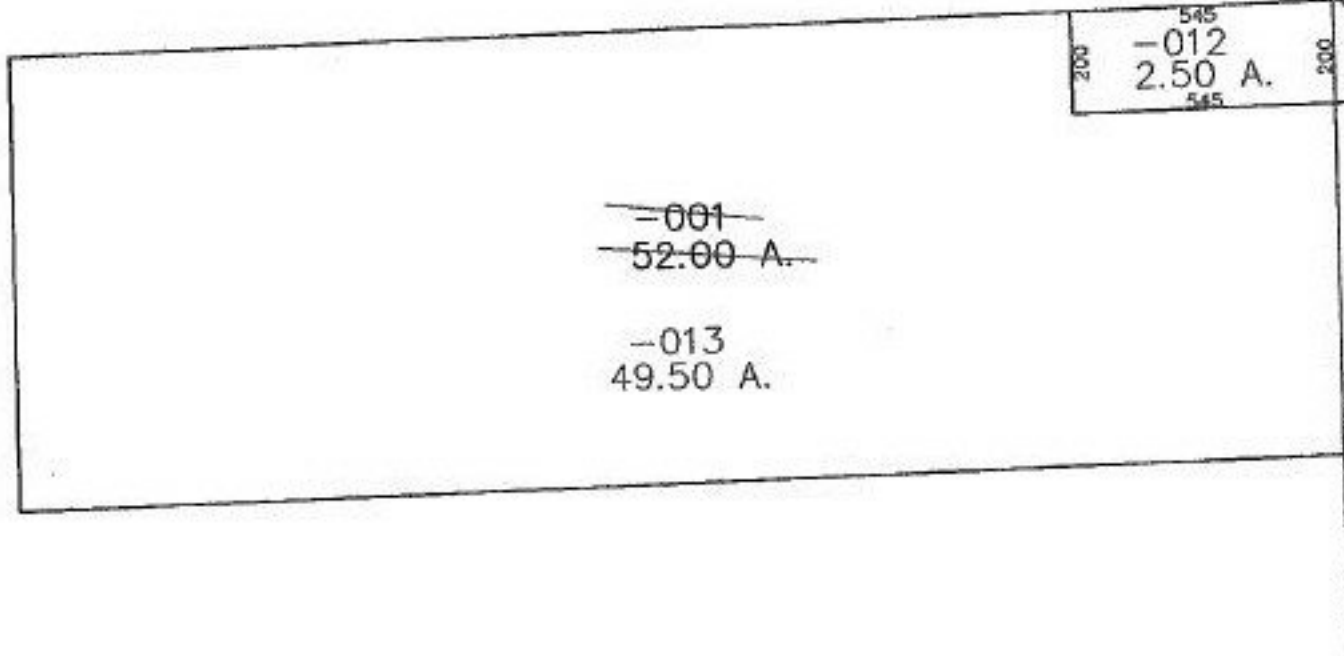

-001-  
52.00 A.

-013  
49.50 A.

545  
-012  
2.50 A.  
545


SURVEYED BY: RODGER G. SIMON

CLOSURE: 0.00 : 10.000

MAP PAGE(S): 14-H

APPROVED BY: JAH DATE: 9-1-00

SCALE: 1" = 400 PRIOR INSTRUMENT: 2000 0678 143

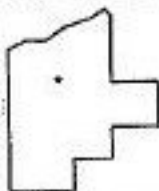

**SPLITS/DEEDS PROCESSED**  
LORAIN COUNTY TAX MAP DEPARTMENT  
226 MIDDLE AVE. ELYRIA, OHIO