
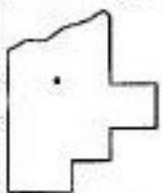


PARENT PARCEL: 04-00-025-000-070, -203, -076

CHILD PARCEL: 04-00-025-000-232, -233

STARTING POINT: CENTERLINES OF LEAR NAGEL & MILLS RD.

NO. 00558

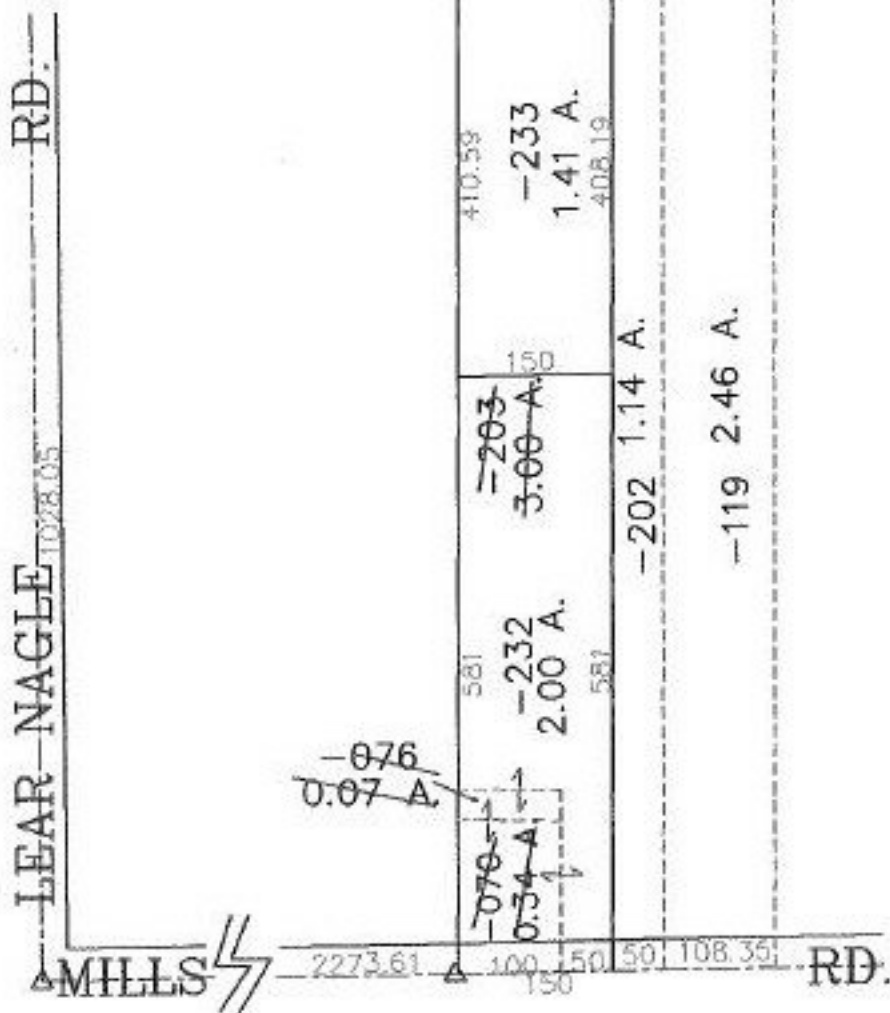

SPLITS/DEEDS PROCESSED
 LORAIN COUNTY TAX MAP DEPARTMENT
 226 MIDDLE AVE. ELYRIA, OHIO

SURVEYED BY: DANE A. HAPONEK
 CLOSURE: 0.08 : 10.000
 MAP PAGE(S): 4-00-025-F
 APPROVED BY: JAH DATE: 8-29-00
 SCALE: 1" = 200 PRIOR INSTRUMENT: 1124/616

1128/604
505/152