


RASTER

PARENT PARCEL: 06-25-021-104-008

CHILD PARCEL: 06-25-021-104-044 & -045

STARTING POINT: S.W. CORNER OF S\ 169

NO. 00559

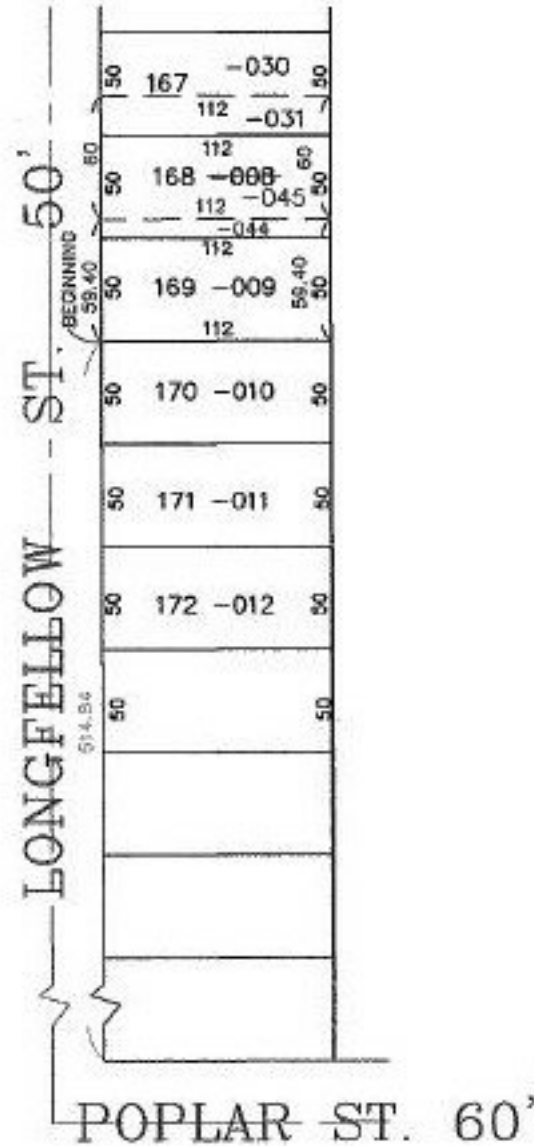

**SPLITS/DEEDS PROCESSED**

LORAIN COUNTY TAX MAP DEPARTMENT  
226 MIDDLE AVE. ELYRIA, OHIO

SURVEYED BY: DAVID L. ELWELL

CLOSURE: 0.00 : 10.000

MAP PAGE(S): 6-88

APPROVED BY: J.H. & TJS DATE: 08/31/00

SCALE: 1" = 100' PRIOR INSTRUMENT: 19990661815