


FASTER

PARENT PARCEL: 04-00-011-101-003 & -004  
CHILD PARCEL: 04-00-011-101-066 THRU -068  
STARTING POINT: CL OF DETROIT RD. & CL OF CENTURY LANE

NO. 00568

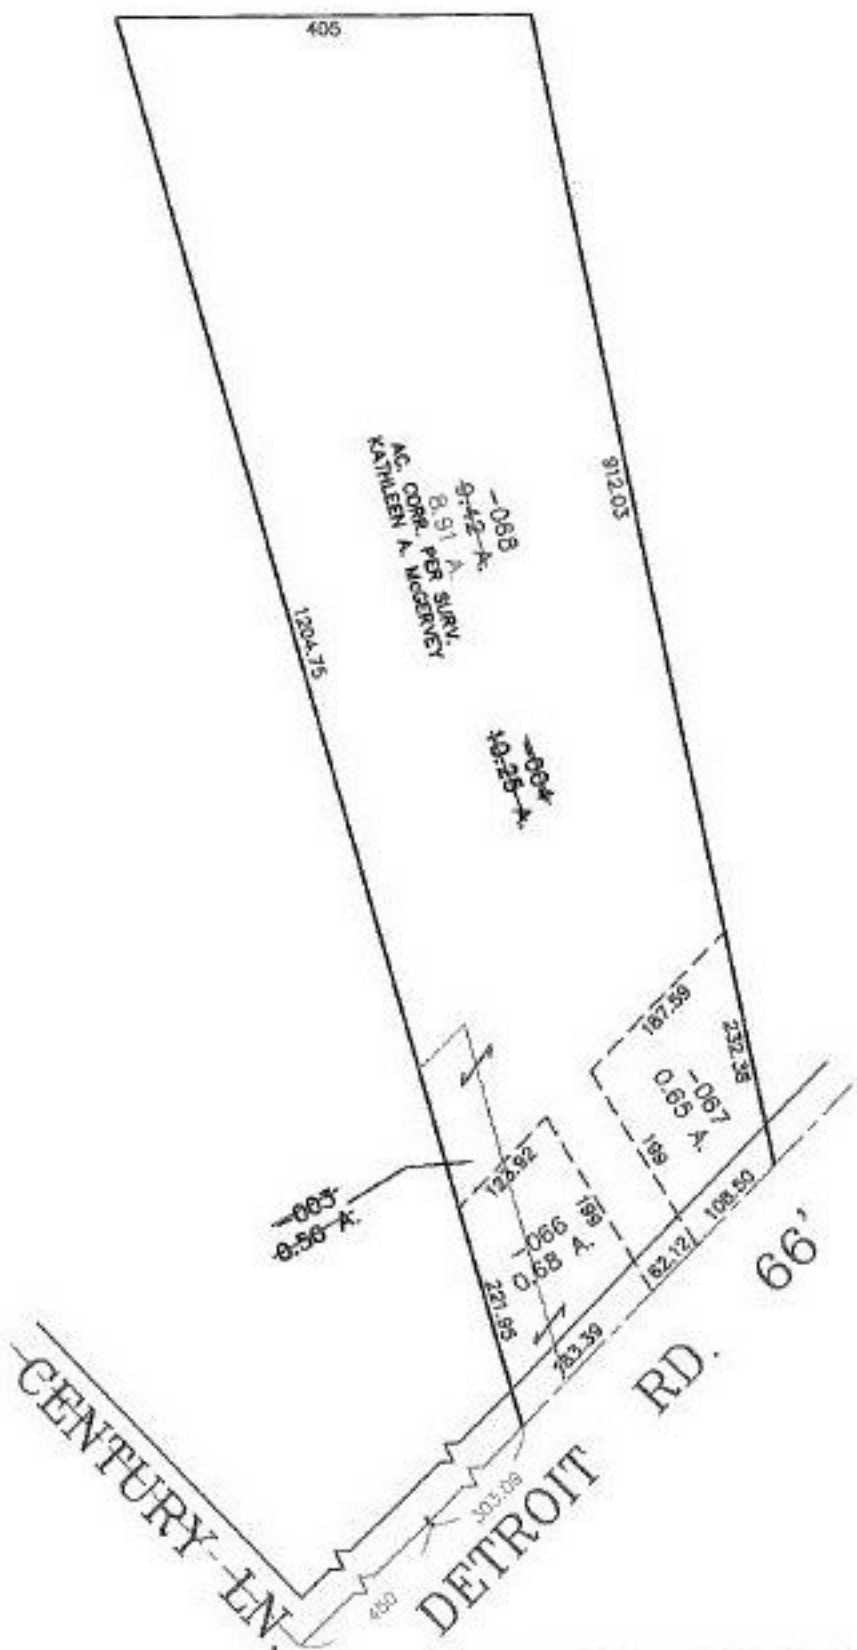

**SPLITS/DEEDS PROCESSED**  
LORAIN COUNTY TAX MAP DEPARTMENT  
226 MIDDLE AVE. ELYRIA, OHIO

SURVEYED BY: KATHLEEN A. MCGERVEY  
CLOSURE: 0.07 : 10.000  
MAP PAGE(S): 04-00-011-A  
APPROVED BY: TJS DATE: 09/22/00  
SCALE: 1" = 200' PRIOR INSTRUMENT: 990647620