



MASTER

PARENT PARCEL: 16-00-043-000-012 & -013
CHILD PARCEL: 16-00-043-000-030 THRU -032
STARTING POINT: CL OF MENNELL RD. & CL OF S.R. 303


NO. 00570

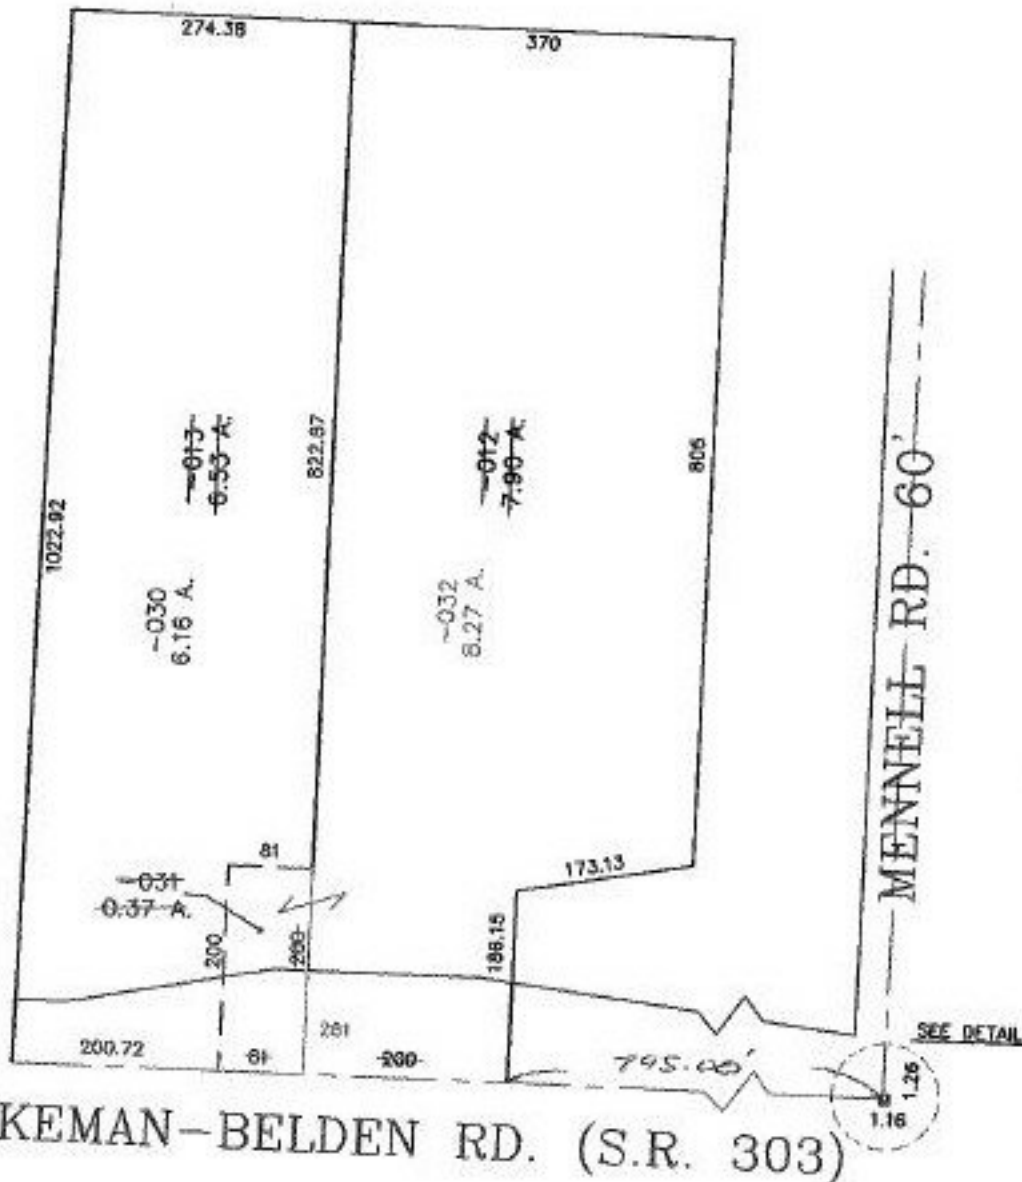

DETAIL

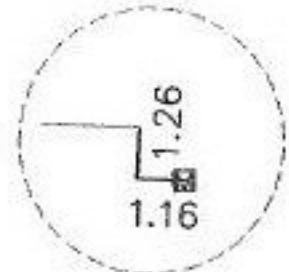

SEE DETAIL

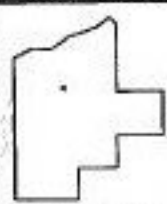

SPLITS/DEEDS PROCESSED
LORAIN COUNTY TAX MAP DEPARTMENT
226 MIDDLE AVE. ELYRIA, OHIO

SURVEYED BY: RODGER C. SIMON
CLOSURE: 0.05 : 10,000
MAP PAGE(S): 16-A
APPROVED BY: TJS DATE: 10/02/00
SCALE: 1" = 200' PRIOR INSTRUMENT: 990635498