


RASTER

NO. 00573

PARENT PARCEL: 03-00-066-101-002, -003


CHILD PARCEL: 03-00-066-101-008, -009

STARTING POINT: CENTERLINE OF GULF RD. & SHEFFIELD FRENCH CREEK RD.

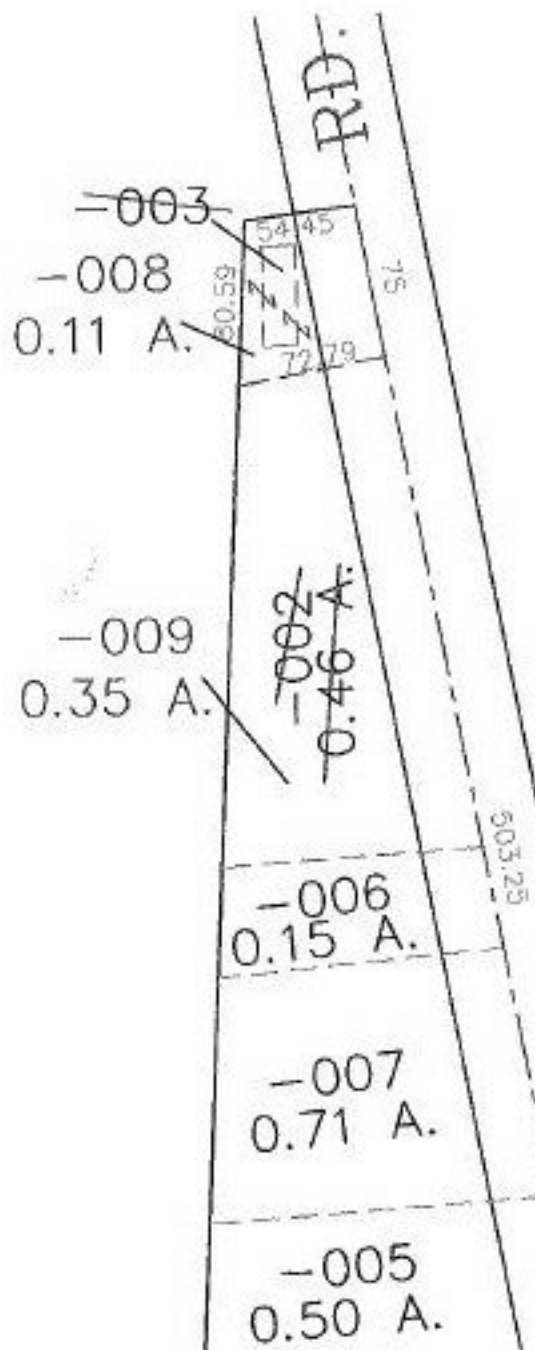

O.L. 66  
O.L. 67

GULF RD.  
SHEFFIELD-FRENCH CREEK RD.

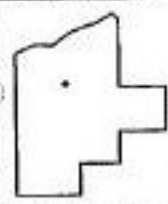

**SPLITS/DEEDS PROCESSED**

LORAIN COUNTY TAX MAP DEPARTMENT  
226 MIDDLE AVE. ELYRIA, OHIO

SURVEYED BY: M.G. HURA  
 CLOSURE: 0.02 : 10,000  
 MAP PAGE(S): 3-00-066-B  
 APPROVED BY: JAH DATE: 10-5-00  
 SCALE: 1" = 100' PRIOR INSTRUMENT: 20000685757