


EASTER

PARENT PARCEL: 05-00-007-000-020

NO. 00595

CHILD PARCEL: 05-00-007-000-021 THRU -023

STARTING POINT: CENTERLINE OF MIDDLE RIDGE RD. & O.L. 6

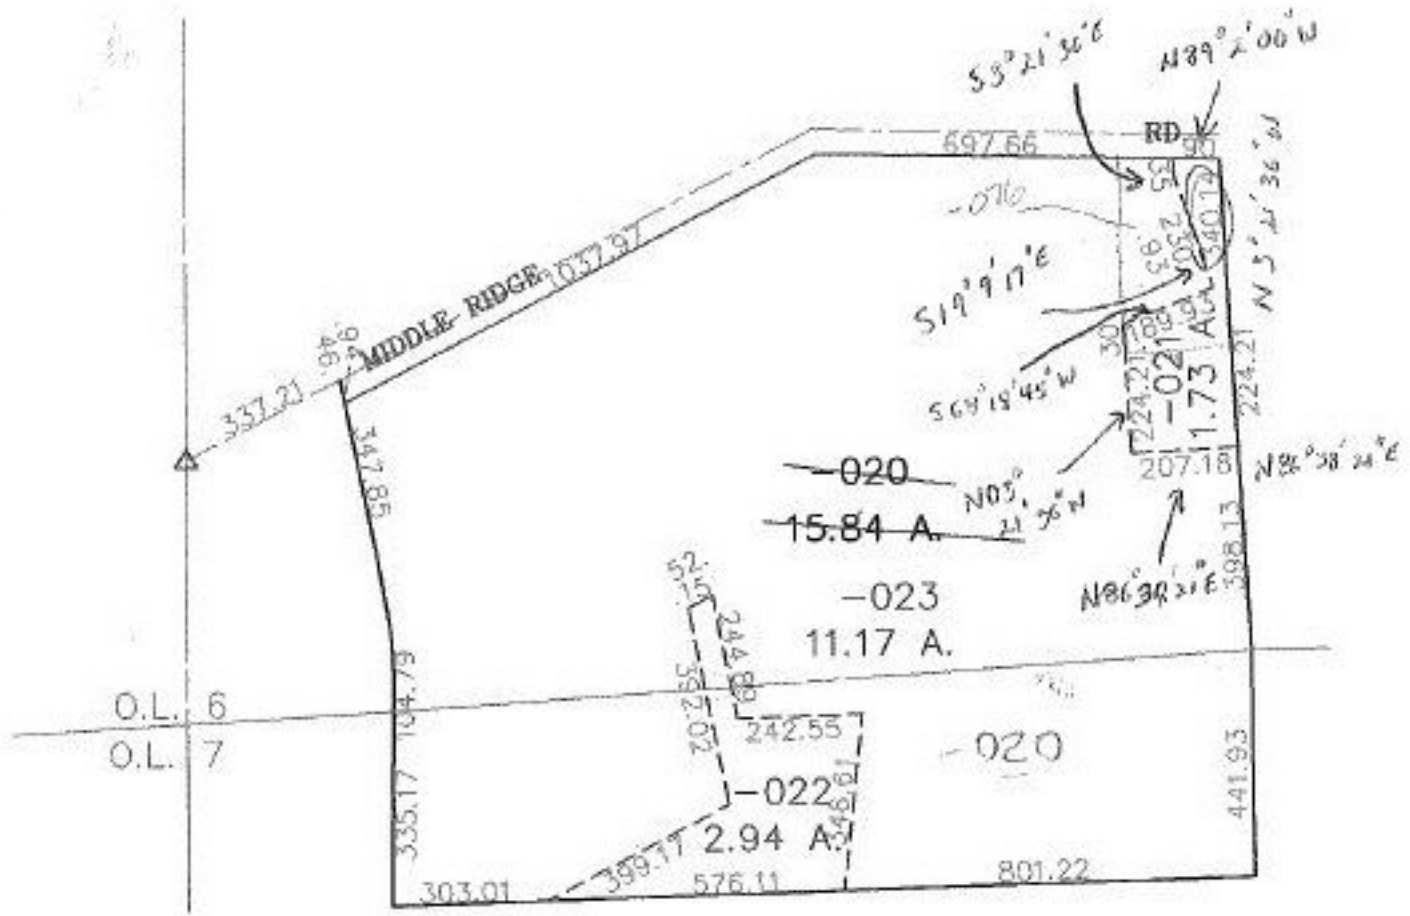

**SPLITS/DEEDS PROCESSED**  
**LORAIN COUNTY TAX MAP DEPARTMENT**  
 228 MIDDLE AVE. ELYRIA, OHIO

SURVEYED BY: PHILLIP A. ROSEBECK  
 CLOSURE: 0.00 : 10,000  
 MAP PAGE(S): 5-E  
 APPROVED BY: JAH DATE: 11-3-00  
 SCALE: 1" = 400' PRIOR INSTRUMENT: