


EASTER

PARENT PARCEL: 07-00-032-000-044, THRU -048

CHILD PARCEL: 07-00-032-000-054

STARTING POINT: CENTERLINE OF BARRES RD. & O.L. 32

NO. 00598

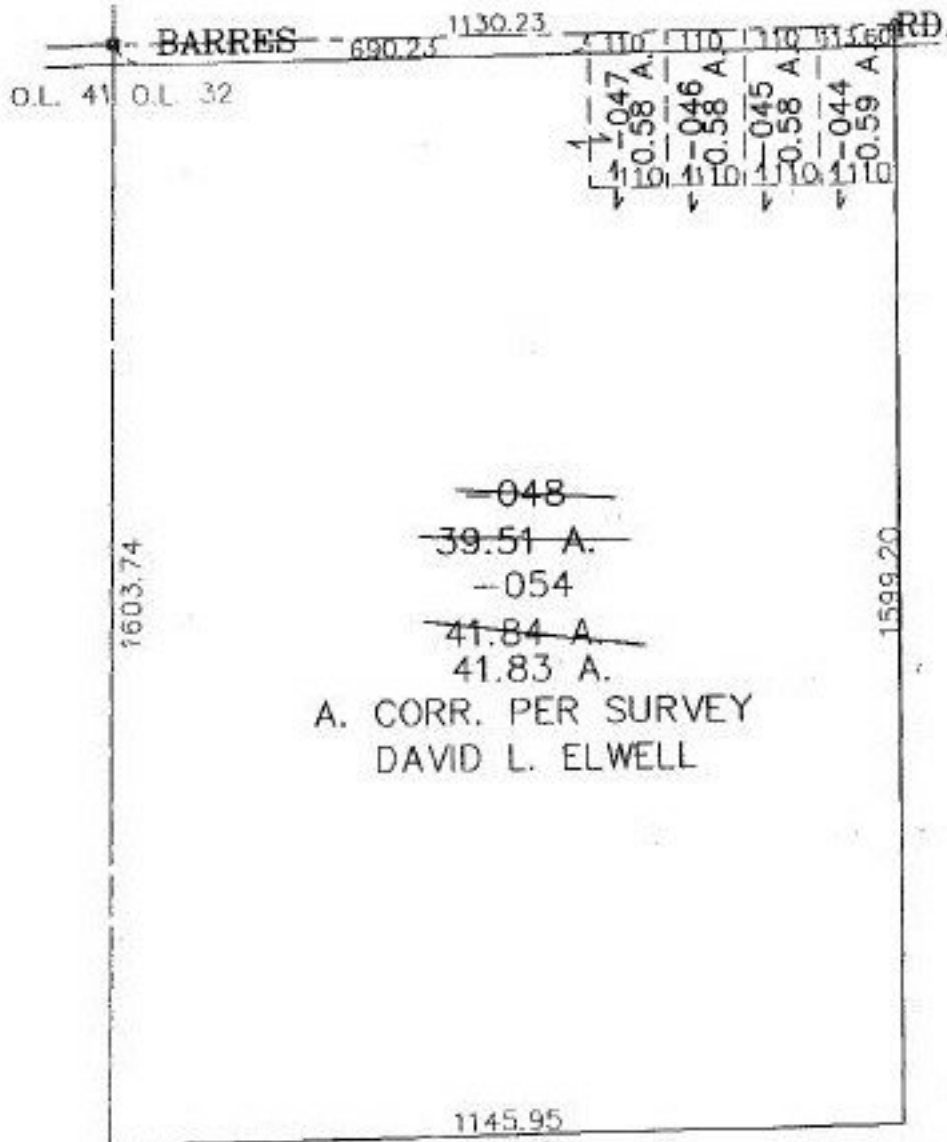

- Prior Inst. ref.
- 048 OR 1472/789
 - 047 OR 1472/787
 - 046 OR 1472/785
 - 045 OR 1472/783
 - 044 OR 1472/781



SPLITS/DEEDS PROCESSED
 LORAIN COUNTY TAX MAP DEPARTMENT
 226 MIDDLE AVE. ELYRIA, OHIO

SURVEYED BY: DAVID L. ELWELL
 CLOSURE: 0.03 : 10.000
 MAP PAGE(S): 7-B
 APPROVED BY: JAH DATE: 11-6-00
 SCALE: 1" = 300' PRIOR INSTRUMENT: