
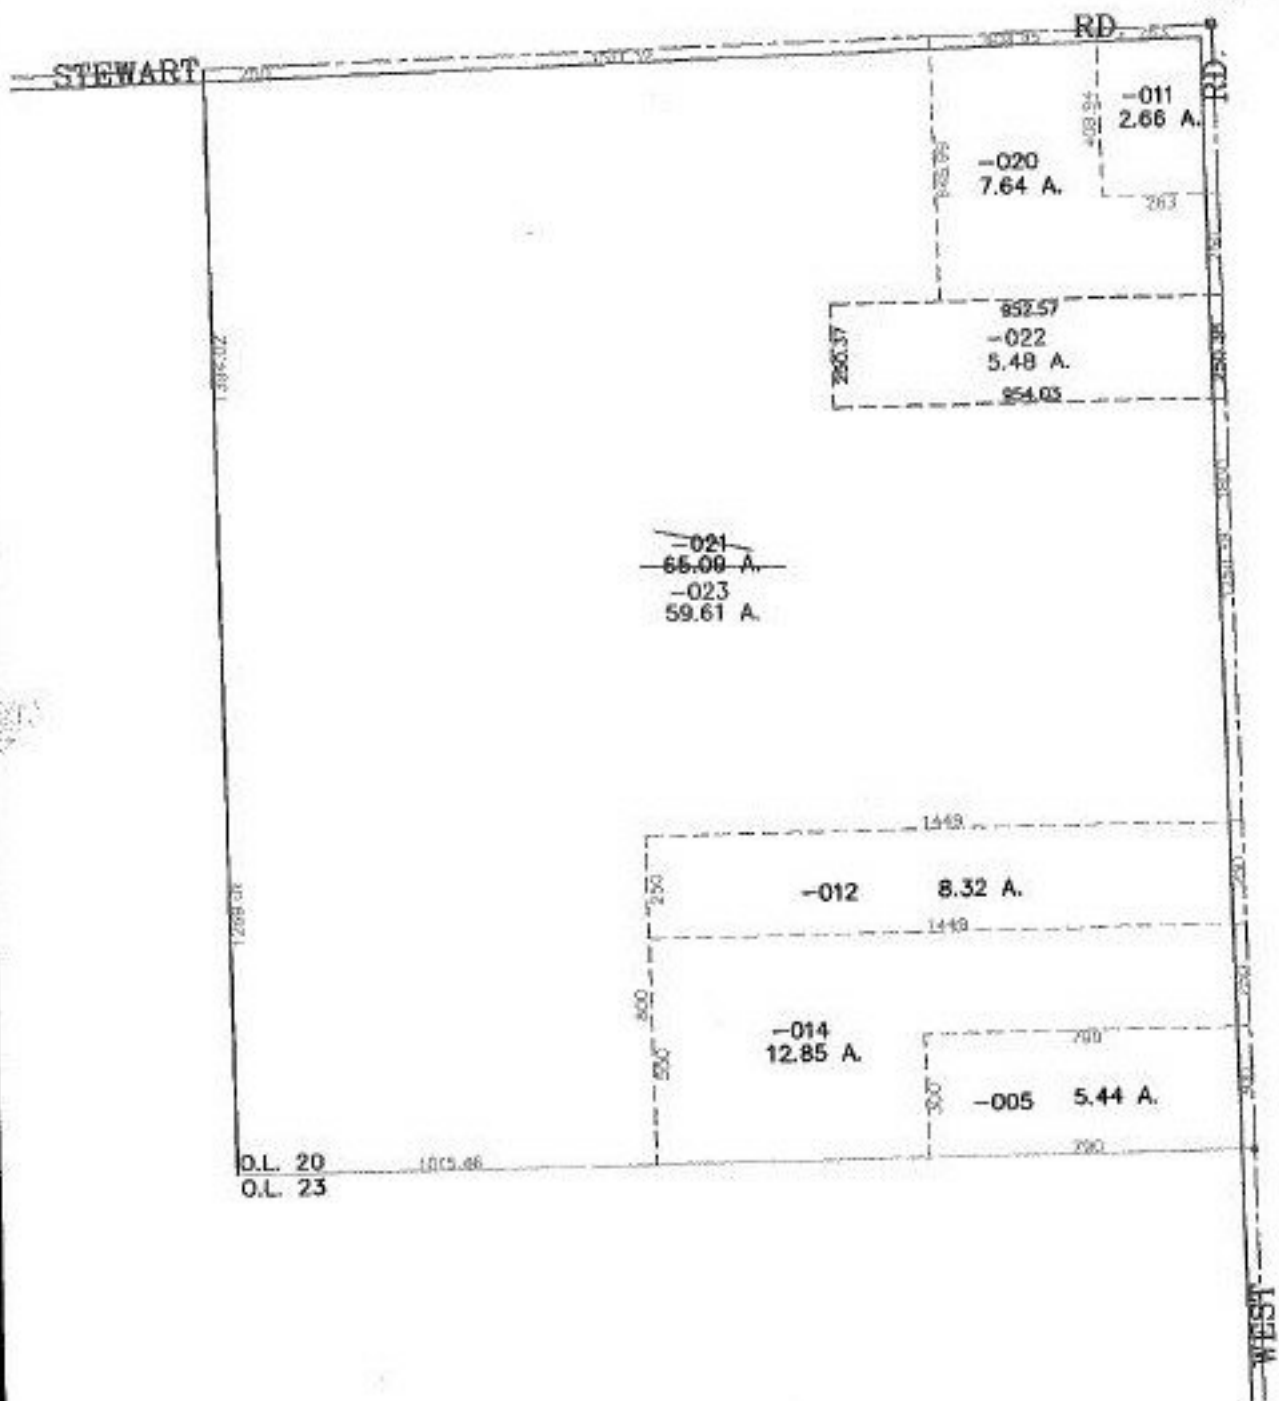


FASTER

PARENT PARCEL: 21-17-020-000-021
CHILD PARCEL: 21-17-020-000-022, -023
STARTING POINT: CENTERLINE OF WEST RD. & O.L. 20

NO. 00601

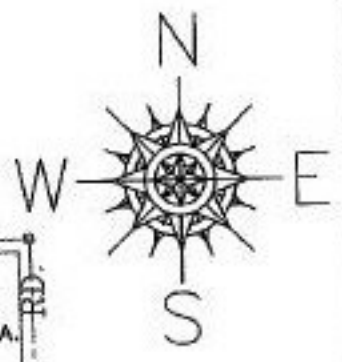

SPLITS/DEEDS PROCESSED
LORAIN COUNTY TAX MAP DEPARTMENT
226 MIDDLE AVE. ELYRIA, OHIO

SURVEYED BY: ANDREW G. PLANET
CLOSURE: 0.02 : 10.000
MAP PAGE(S): 21-H
APPROVED BY: JAH DATE: 11-19-00
SCALE: 1" = 500 PRIOR INSTRUMENT: 985573441369