


PARENT PARCEL: 01-00-046-000-018

CHILD PARCEL: 01-00-046-036, -037

STARTING POINT: CENTERLINE OF VERMILION & NORTH RIDGE RD.

NO. 00608

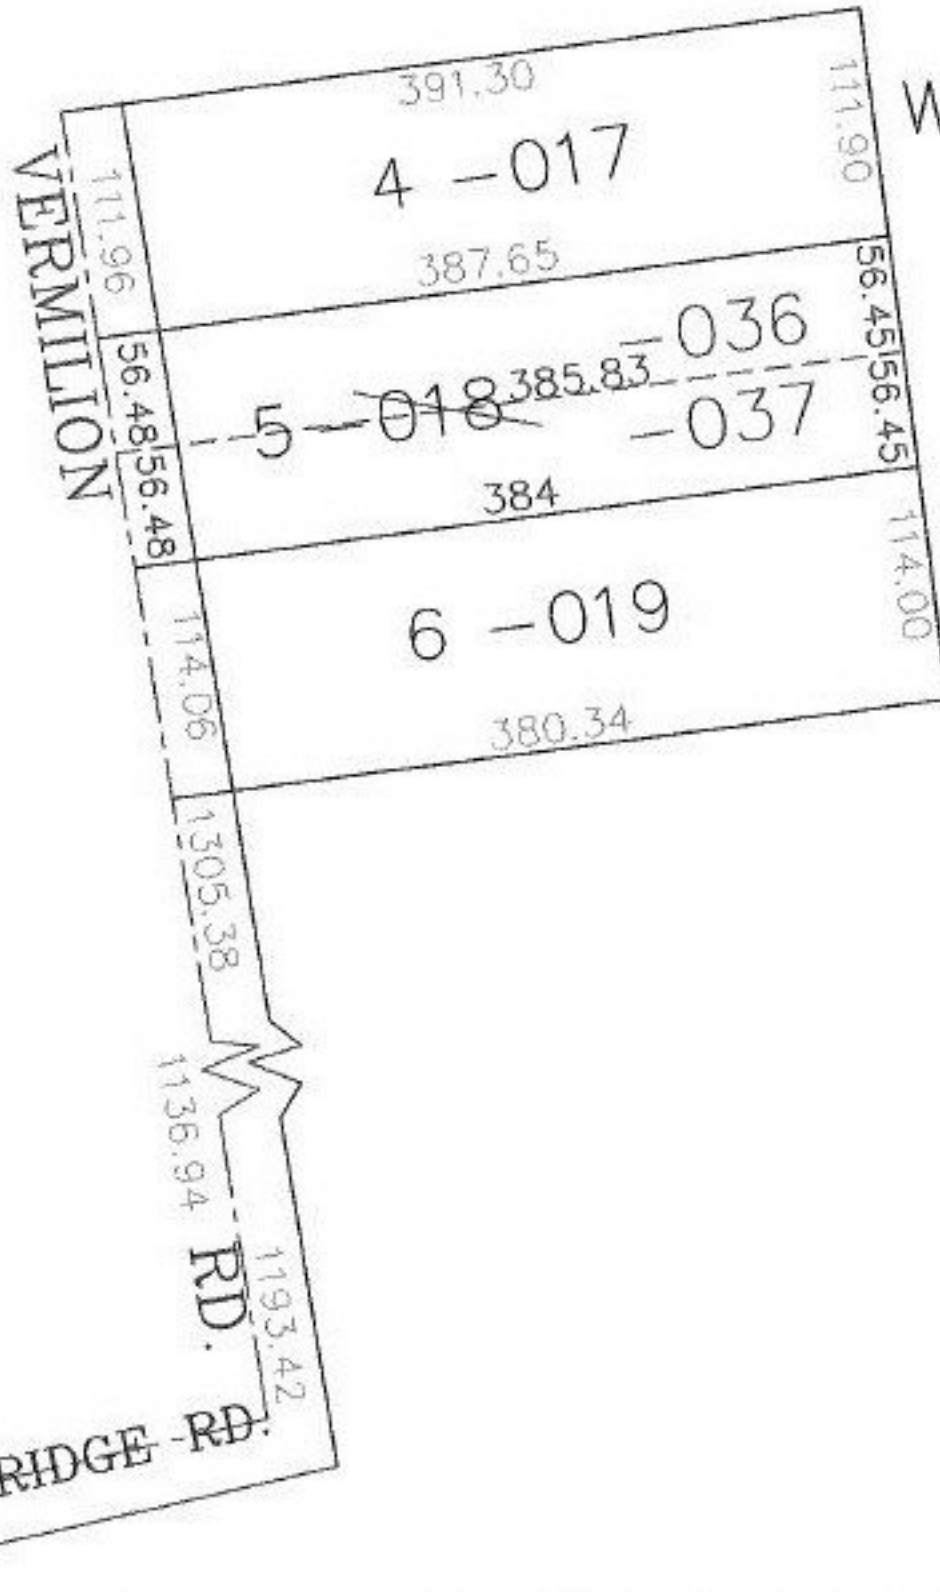

SPLITS/DEEDS PROCESSED

LORAIN COUNTY TAX MAP DEPARTMENT
226 MIDDLE AVE. ELYRIA, OHIO

SURVEYED BY: VINCENT C. MCGERVEY

CLOSURE: 0.04 : 10,000

MAP PAGE(S): 01-00-046-B

APPROVED BY: JAH DATE: 11-28-00

SCALE: 1" = 100' PRIOR INSTRUMENT: 7051641625