

MASTER



NO. 00609

PARENT PARCEL: 04-00-015-101-042 & -044
CHILD PARCEL: 04-00-015-000-115
STARTING POINT: CENTERLINE OF DETROIT RD. & POINT OF FRENCH CREEK MEDICAL CAMPUS



FRENCH CREEK
MEDICAL CAMPUS
VOL. 58 PG. 56-57

VOIDED
8-21-03

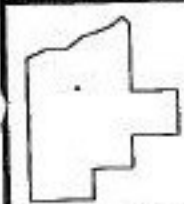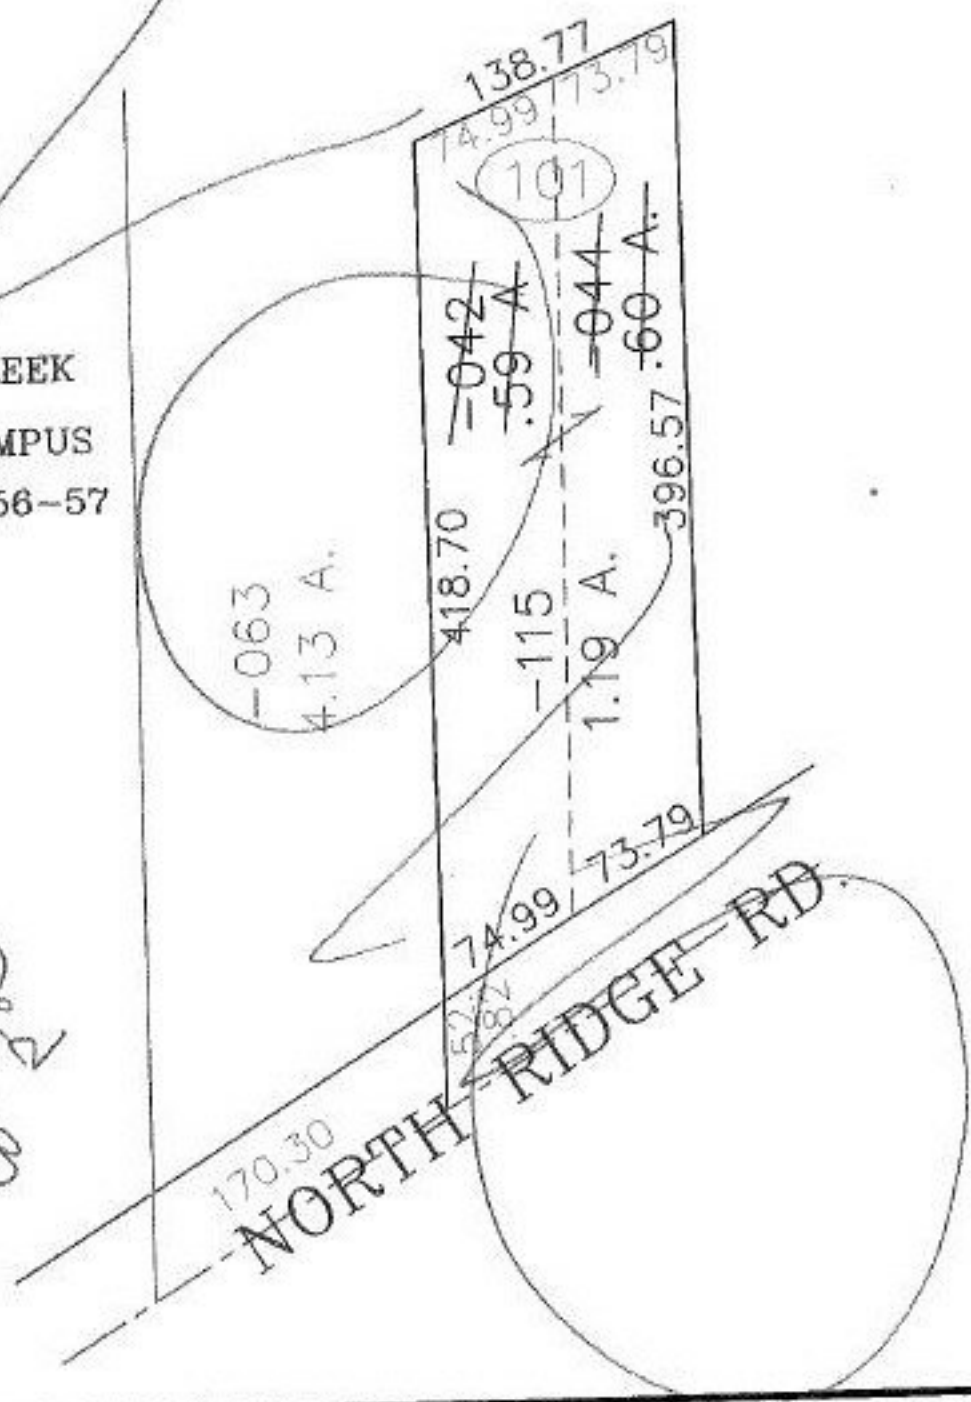

SPLITS/DEEDS PROCESSED
LORAIN COUNTY TAX MAP DEPARTMENT
226 MIDDLE AVE. ELYRIA, OHIO

SURVEYED BY: JOHN H. CRAWFORD
CLOSURE: 0.03 : 10.000
MAP PAGE(S): 04-00-015-B
APPROVED BY: JAH DATE: 12-6-00
SCALE: 1" = 100' PRIOR INSTRUMENT: 20000714679