


MASTER

PARENT PARCEL: 21-05-004-000-022

CHILD PARCEL: 21-05-004-000-033, -034


STARTING POINT: CENTERLINE OF BURSLEY RD. & O.L. 4

NO. 00614

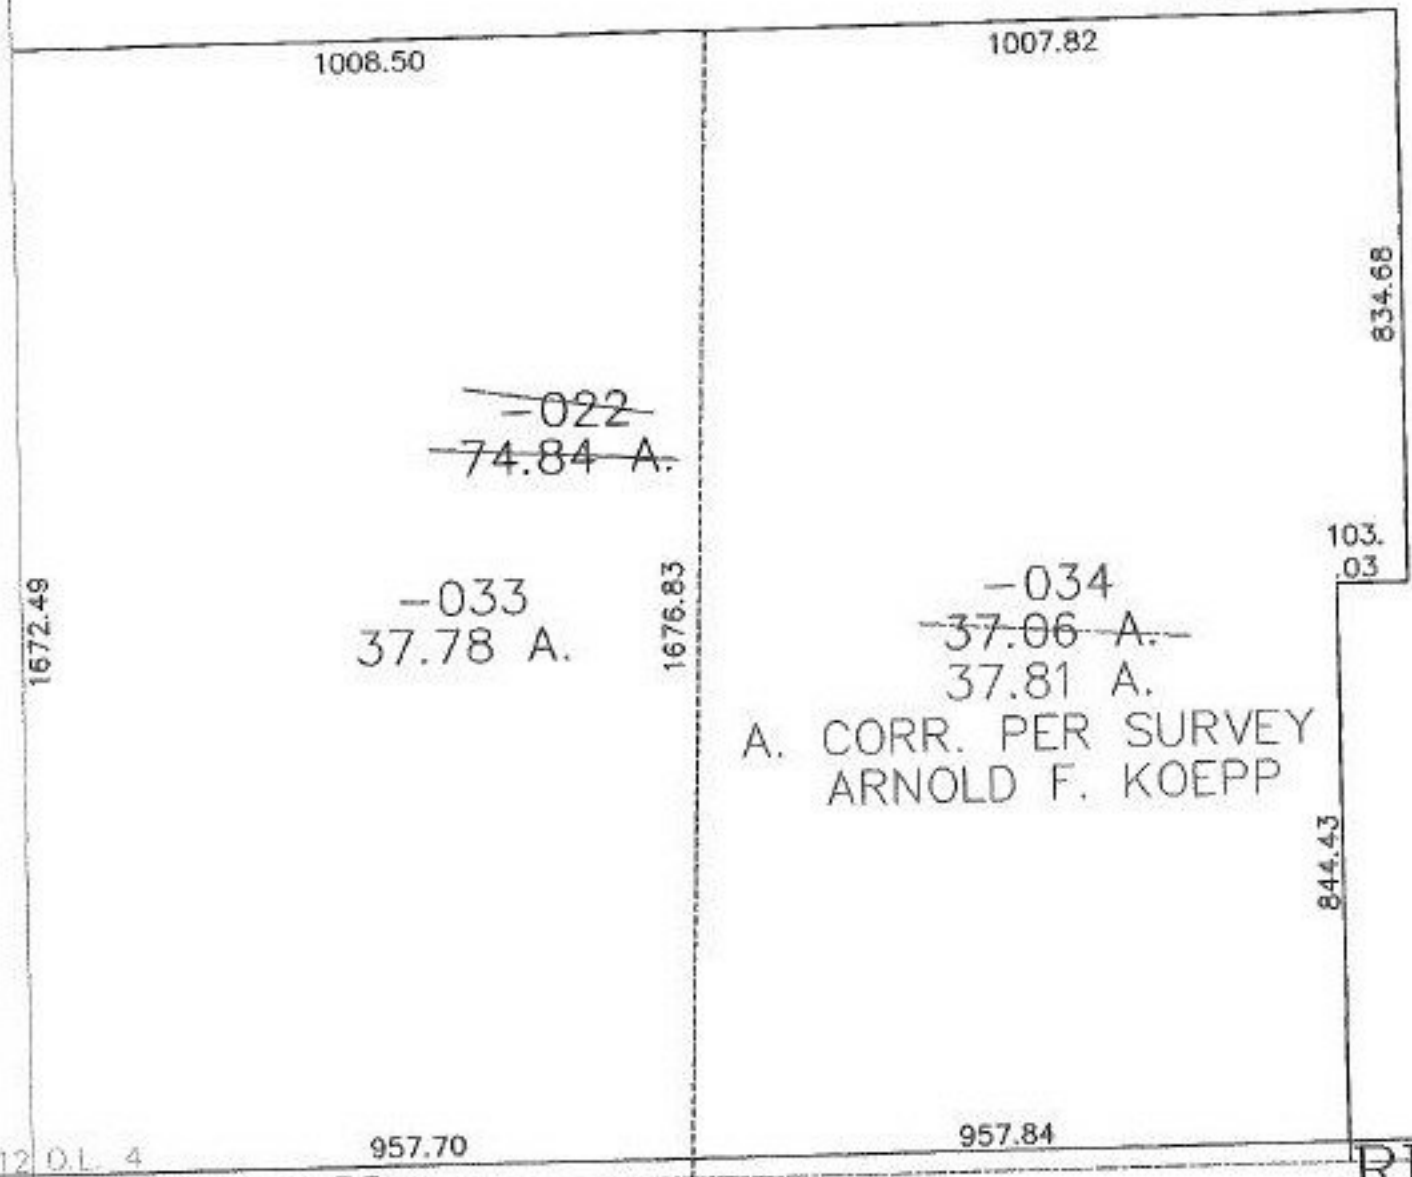

A. CORR. PER SURVEY
ARNOLD F. KOEPP

O.L. 12 O.L. 4 BURSLEY RD.

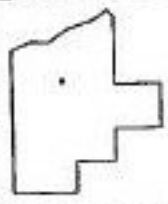

SPLITS/DEEDS PROCESSED
LORAIN COUNTY TAX MAP DEPARTMENT
226 MIDDLE AVE. ELYRIA, OHIO

SURVEYED BY: ARNOLD F. KOEPP
CLOSURE: 0.01 : 10,000
MAP PAGE(S): 21-B
APPROVED BY: JAH DATE: 12-4-00
SCALE: 1" = 300 PRIOR INSTRUMENT: DV 1188/880