

RASTER

PARENT PARCEL: 06-26-063-000-012


CHILD PARCEL: 06-26-063-000-071, -072

STARTING POINT: INTERSECTION OF RIGHT OF WAY LINE OF MIDDLE AVE & 2ND ST.


NO. 00615



MIDDLE AVE.

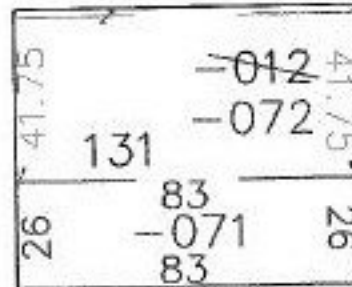

2ND ST.

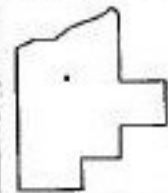

**SPLITS/DEEDS PROCESSED**  
 LORAIN COUNTY TAX MAP DEPARTMENT  
 228 MIDDLE AVE. ELYRIA, OHIO

SURVEYED BY: DOUGLAS H. MOSLEY  
 CLOSURE: 0.00 : 10.000  
 MAP PAGE(S): 6-120  
 APPROVED BY: JAH DATE: 12-4-00  
 SCALE: 1" = 50' PRIOR INSTRUMENT: OR 1474/375