


RASTER

PARENT PARCEL: 03-00-011-102-018,-027,-051,-055,-060,-064,-068,-070,-078,-107,-109  
CHILD PARCEL: 03-00-011-102-110 THRU -112  
STARTING POINT: MON. BOX, CL. OF ABBE RD. & SOUTH LINE OF O.L. 11

NO. 00616



CURVE TABLE						
CURVE	CHORD	BEARING	TAN	DELTA	LENGTH	RADIUS
C1	56.63	S45°27'28"W	40.09	99°07'28"	62.92	40.00
C2	17.98	N74°30'32"E	9.19	24°04'25"	17.84	30.00

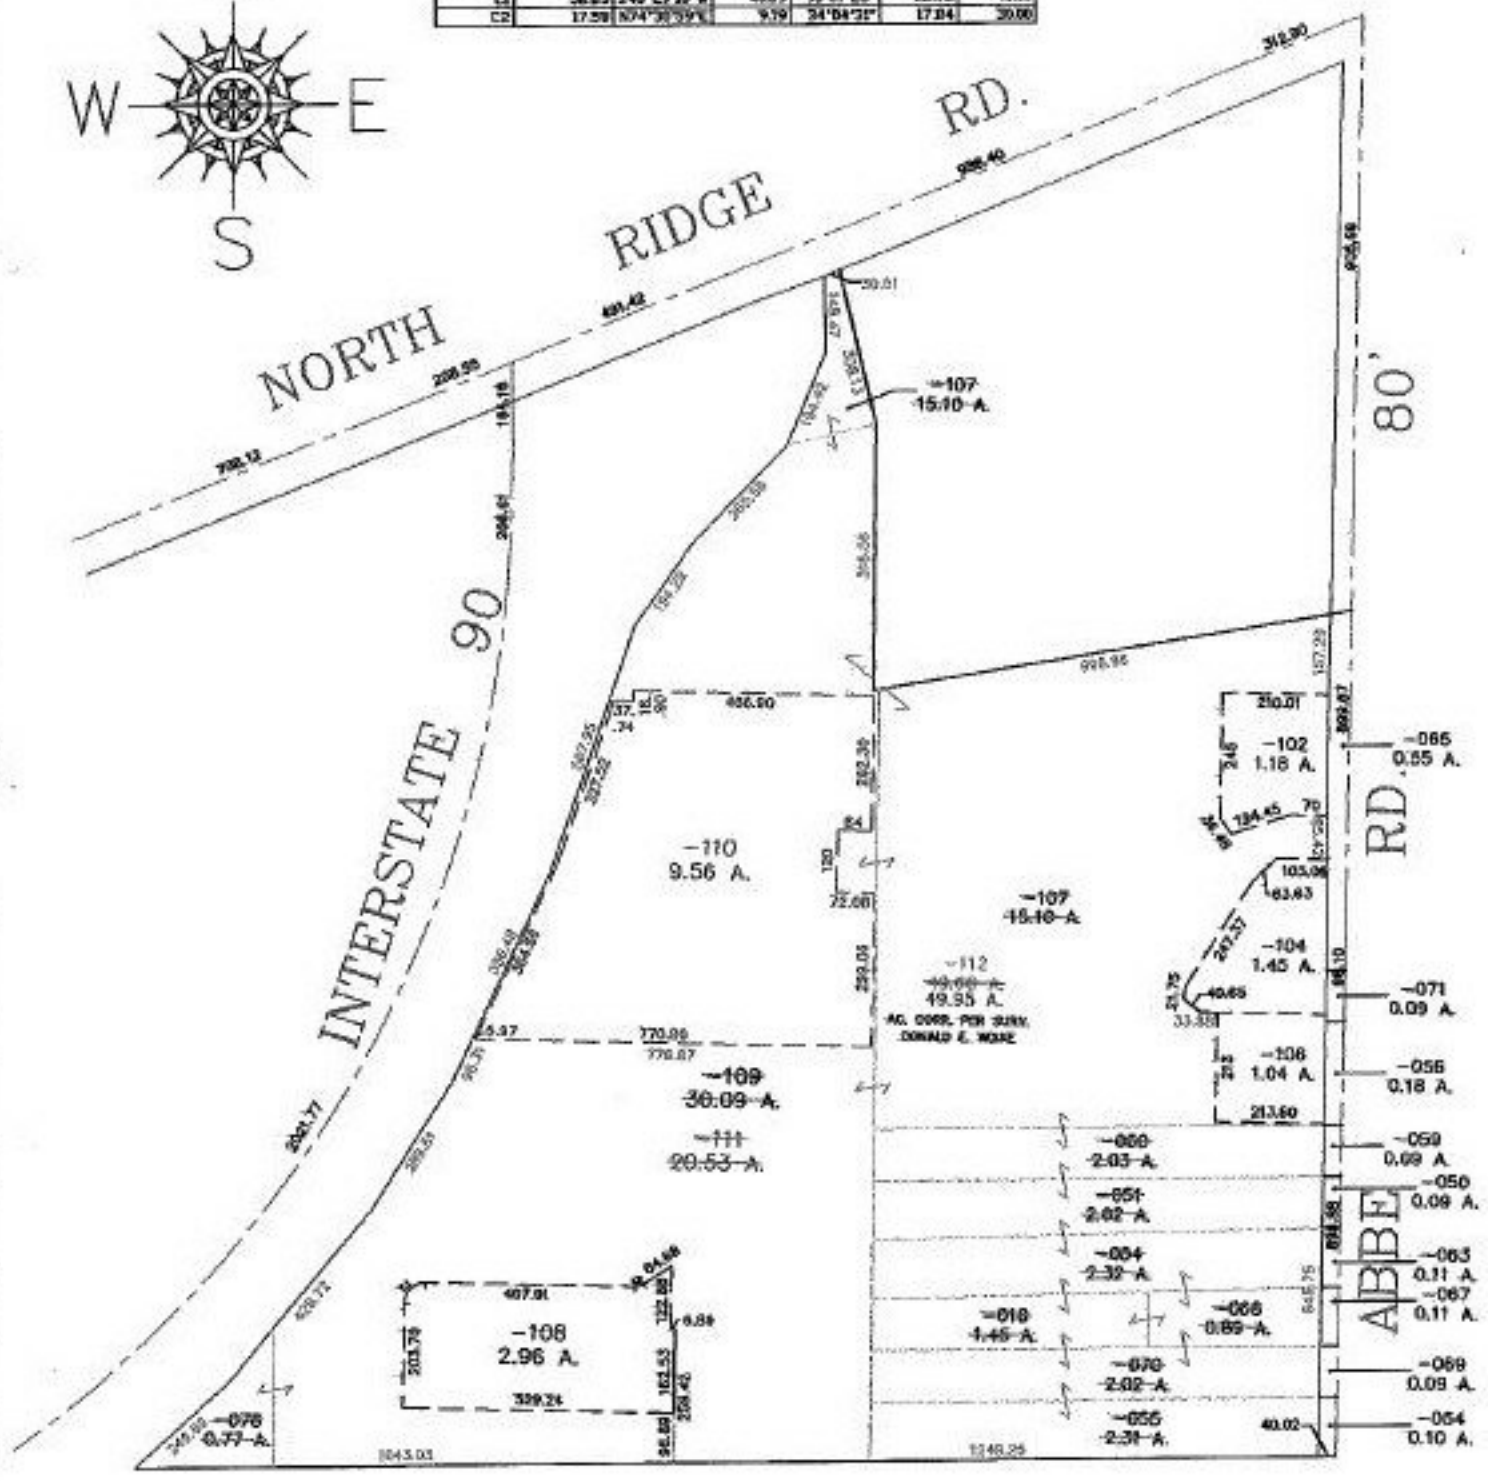

**SPLITS/DEEDS PROCESSED**  
LORAIN COUNTY TAX MAP DEPARTMENT  
226 MIDDLE AVE. ELYRIA, OHIO

SURVEYED BY: DONALD E. WOIKE  
CLOSURE: 0.01 : 10.000  
MAP PAGE(S): 3-00-011-A & B  
APPROVED BY: IJS DATE: 12/14/00  
SCALE: 1" = 400' PRIOR INSTRUMENT: 980573051