


RASTER

PARENT PARCEL: 09-00-088-105-050


CHILD PARCEL: 09-00-088-105-051 & -052

STARTING POINT: R.R.S., CL. OF EAST COLLEGE ST. & CL. OF OBERLIN RD.

NO. 00619

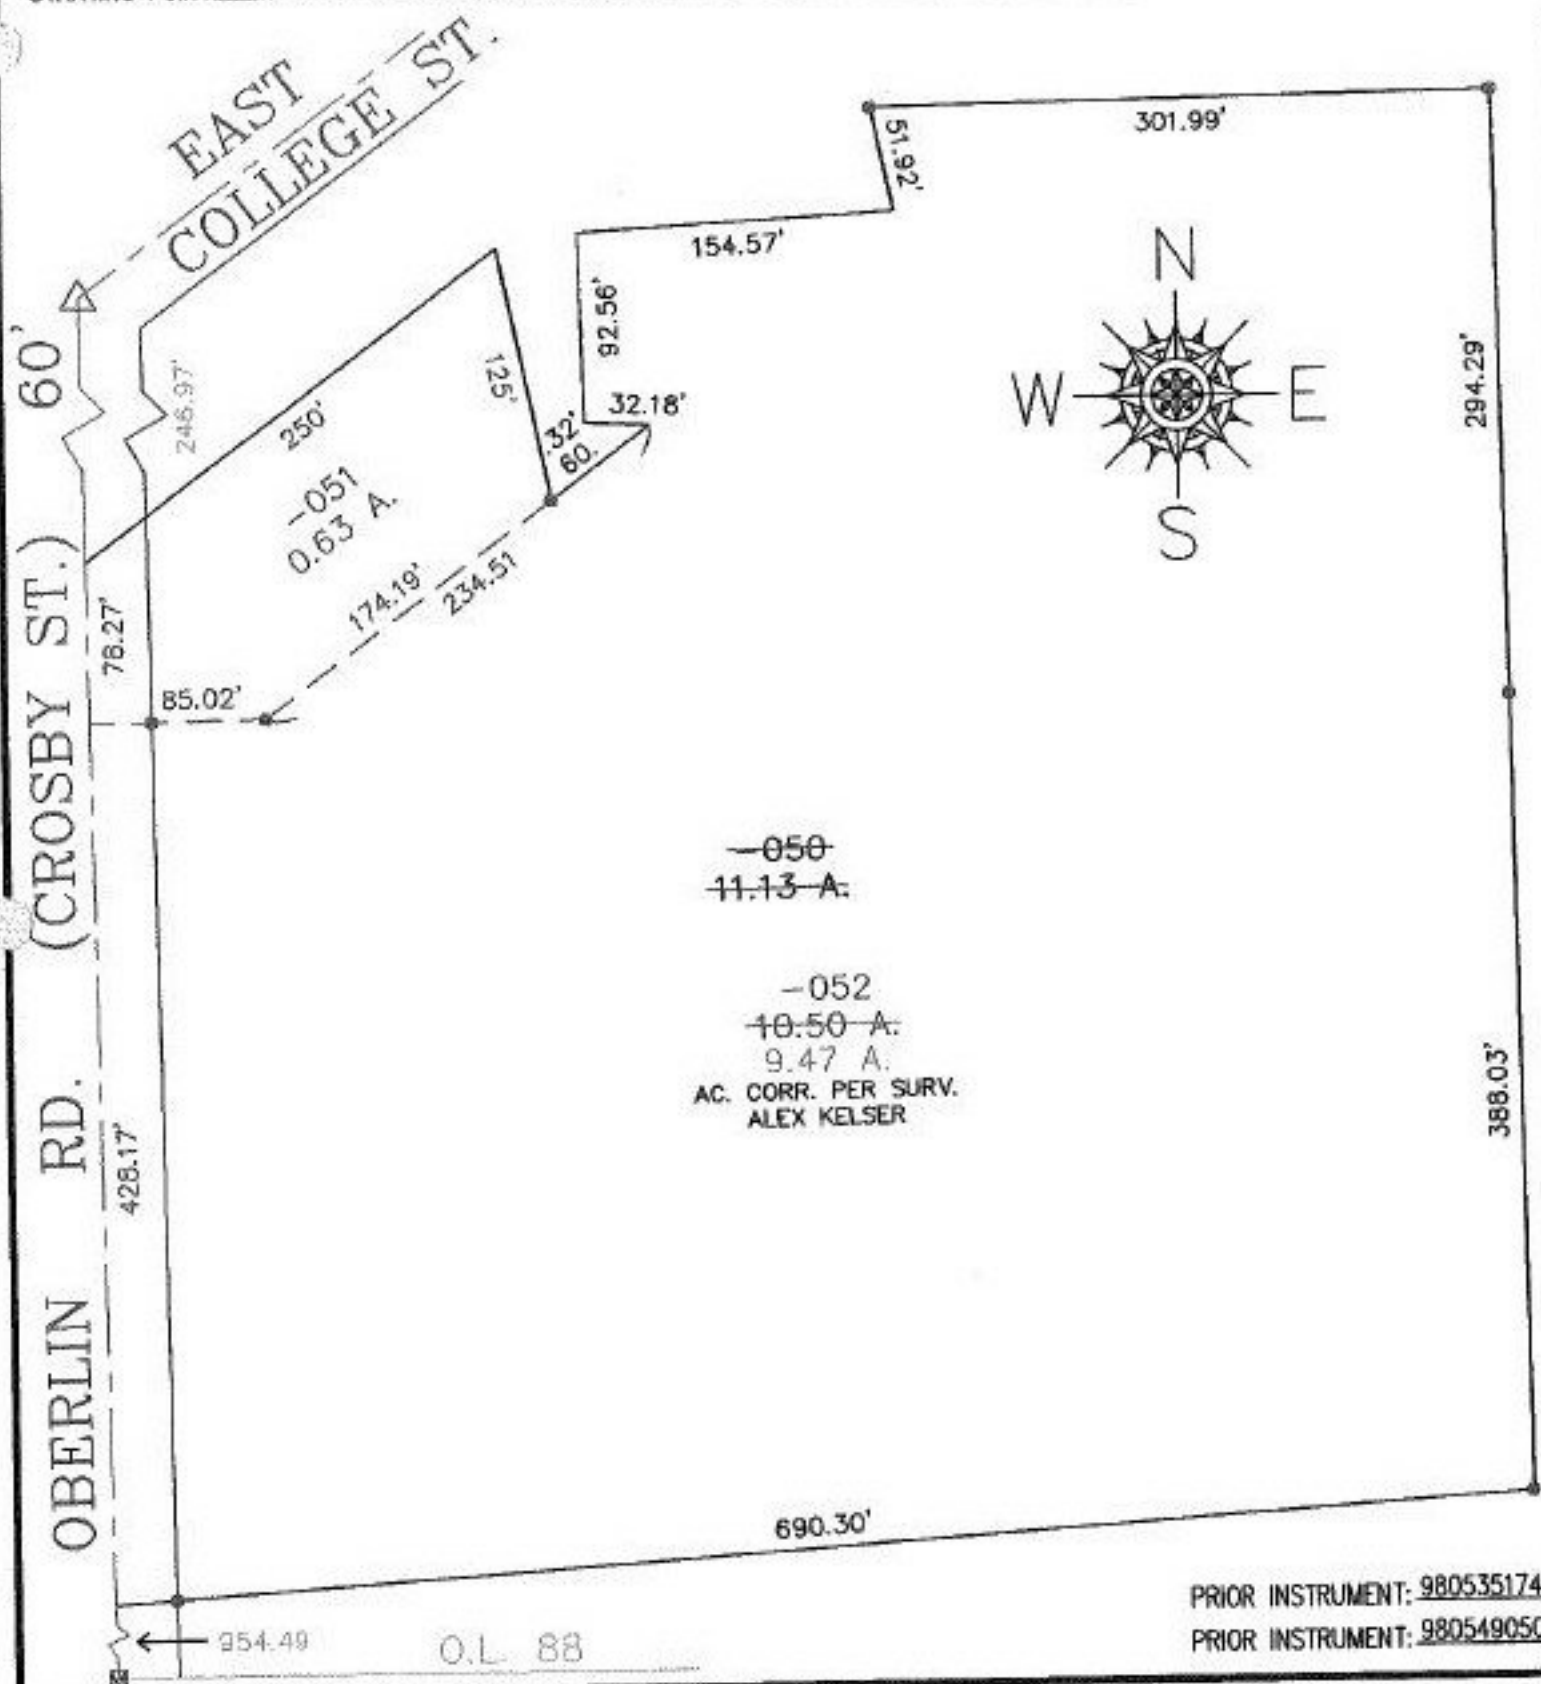

PRIOR INSTRUMENT: 980535174  
PRIOR INSTRUMENT: 980549050

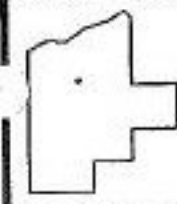

**SPLITS/DEEDS PROCESSED**

LORAIN COUNTY TAX MAP DEPARTMENT  
226 MIDDLE AVE. ELYRIA, OHIO

SURVEYED BY: 0.03 : 10,000  
CLOSURE: ALEX KELSER  
MAP PAGE(S): 9-00-088-A  
APPROVED BY: TJS DATE: 01/02/01  
SCALE: 1" = 100' PRIOR INSTRUMENT: 980535174