


RASTER

PARENT PARCEL: 06-22-004-000-007

CHILD PARCEL: 06-22-004-000-018, -019

STARTING POINT: CENTERLINES OF COLLEGE PARK DR. & ABBE RD.

NO. 00624

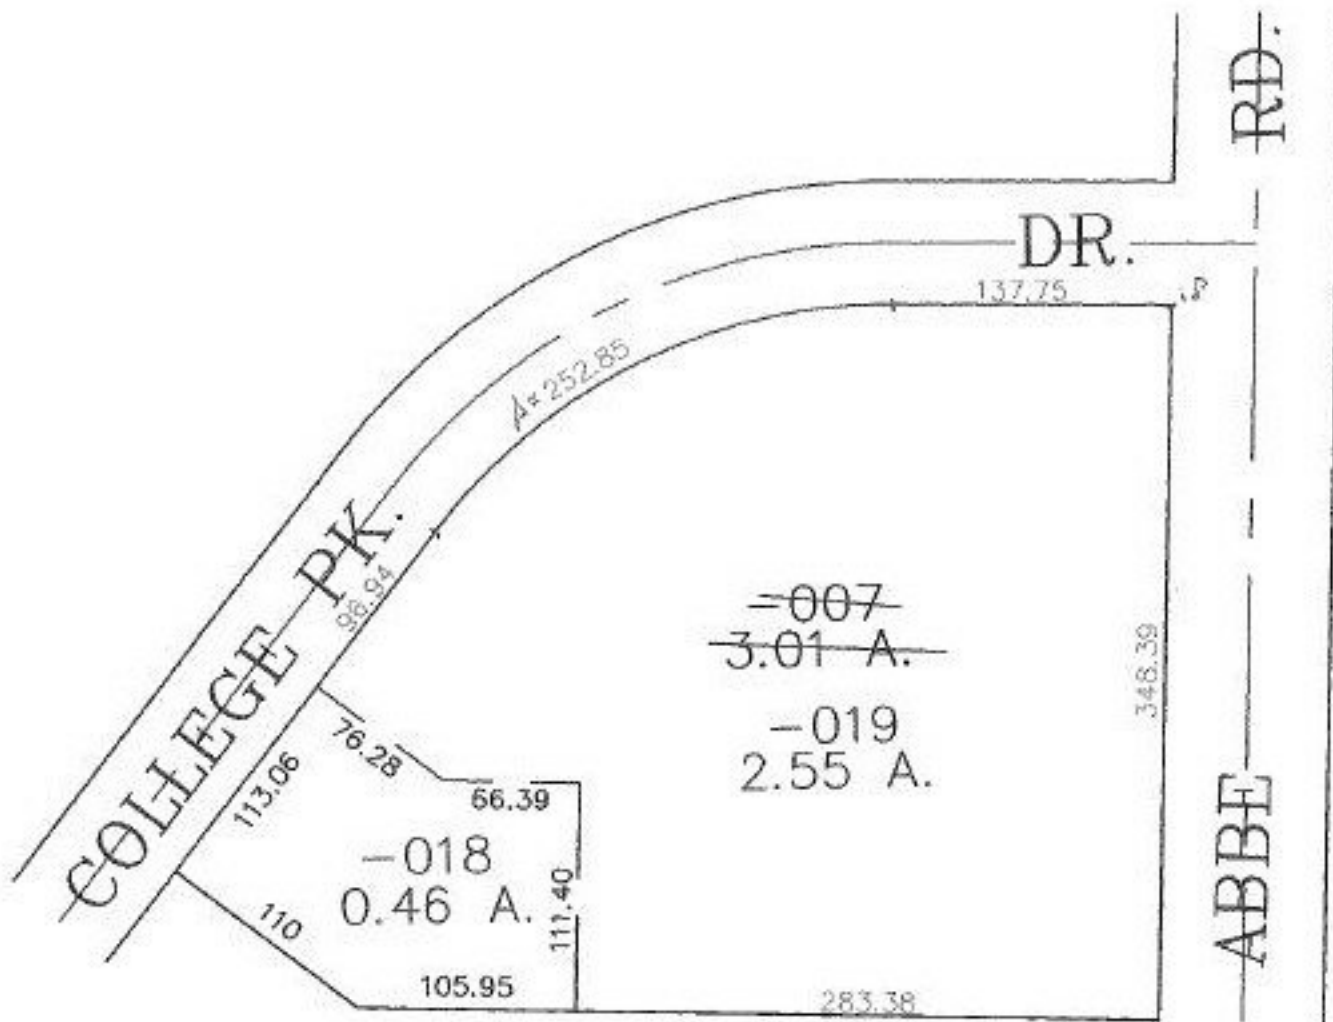

SPLITS/DEEDS PROCESSED
 LORAIN COUNTY TAX MAP DEPARTMENT
 226 MIDDLE AVE. ELYRIA, OHIO

SURVEYED BY: DAVID L. ELWELL
 CLOSURE: 0.07 : 10,000
 MAP PAGE(S): 6-16
 APPROVED BY: JAH DATE: 12-14-00
 SCALE: 1" = 100' PRIOR INSTRUMENT: DV 1031/573