


EASTER

PARENT PARCEL: 01-00-043-000-065

CHILD PARCEL: 01-00-043-000-067, -068

STARTING POINT: CENTERLINES OF NORTH RIDGE RD. & BAUMHART RD.

NO. 00633

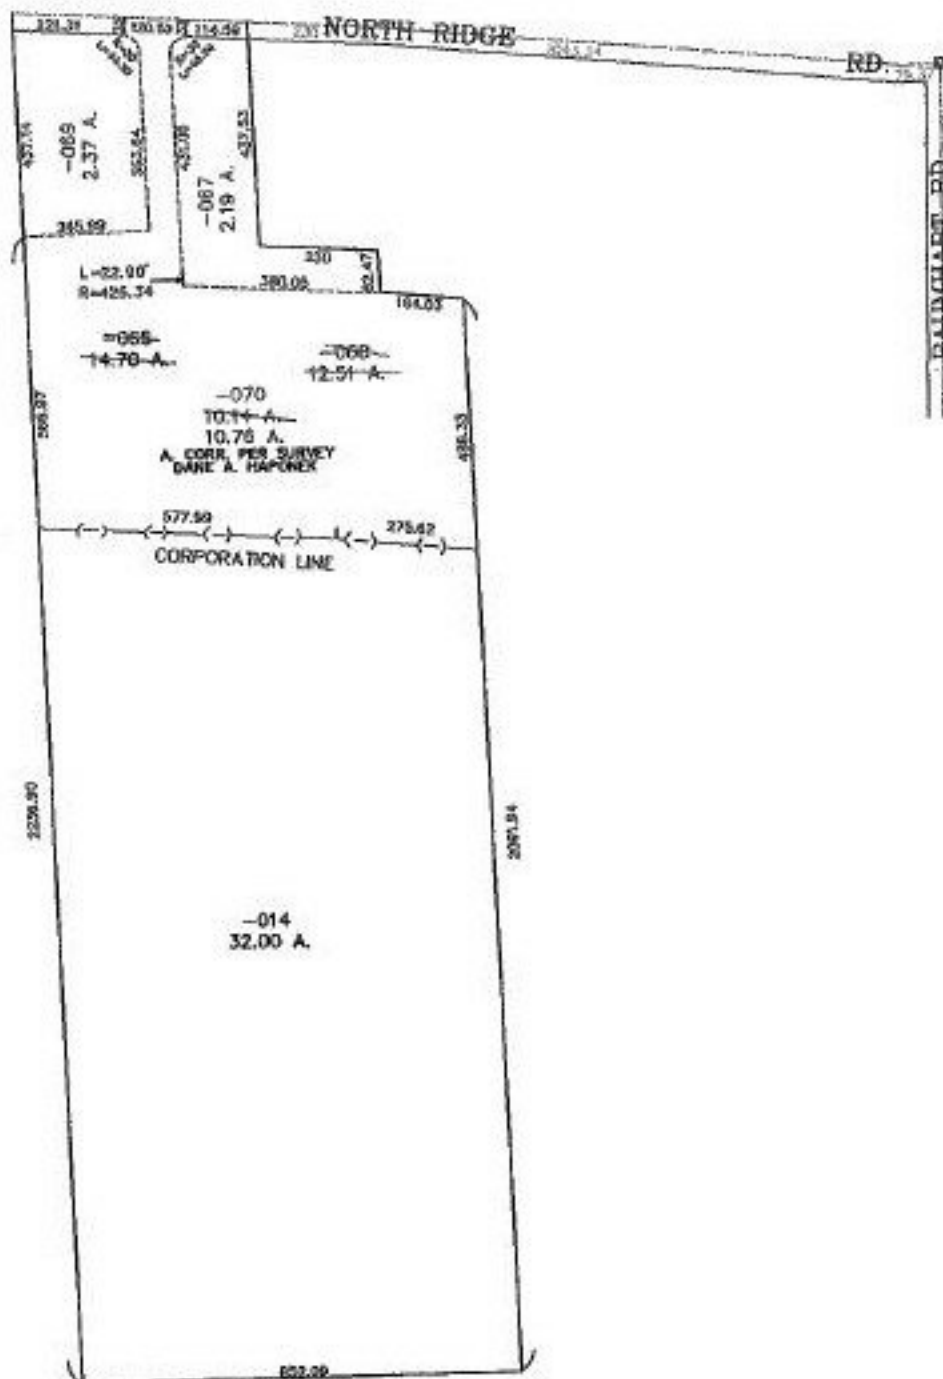

SPLITS/DEEDS PROCESSED
 LORAIN COUNTY TAX MAP DEPARTMENT
 226 MIDDLE AVE. ELYRIA, OHIO

SURVEYED BY: DANE A. HAPONEK
 CLOSURE: 0.07 : 10.000
 MAP PAGE(S): 1-00-043-B
 APPROVED BY: JAH DATE: 1-04-01
 SCALE: 1" = 400' PRIOR INSTRUMENT: 200000676517