


MASTER

PARENT PARCEL: 03-00-008-000-025

CHILD PARCEL: 03-00-008-000-026, -027

STARTING POINT: CENTERLINE OF ABBE RD. & O.L. 8

NO. 00635

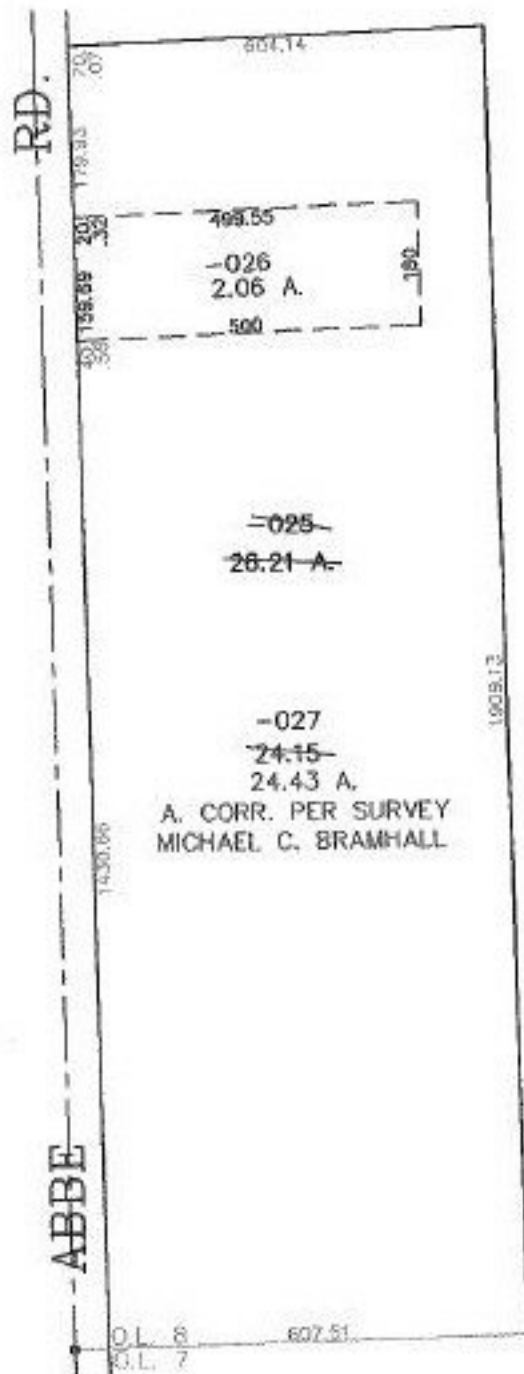

SPLITS/DEEDS PROCESSED
LORAIN COUNTY TAX MAP DEPARTMENT
226 MIDDLE AVE. ELYRIA, OHIO

SURVEYED BY: MICHAEL C. BRAMHALL
 CLOSURE: 0.03 : 10,000
 MAP PAGE(S): 03-00-008-A
 APPROVED BY: JAH DATE: 1-2-01
 SCALE: 1" = 300' PRIOR INSTRUMENT: 7187491650