


PARENT PARCEL: 04-00-023-108-057

CHILD PARCEL: 04-00-023-108-126, -127

STARTING POINT: CENTERLINE OF SCHWARTZ RD. & JAYCOX RD.

NO. 00641

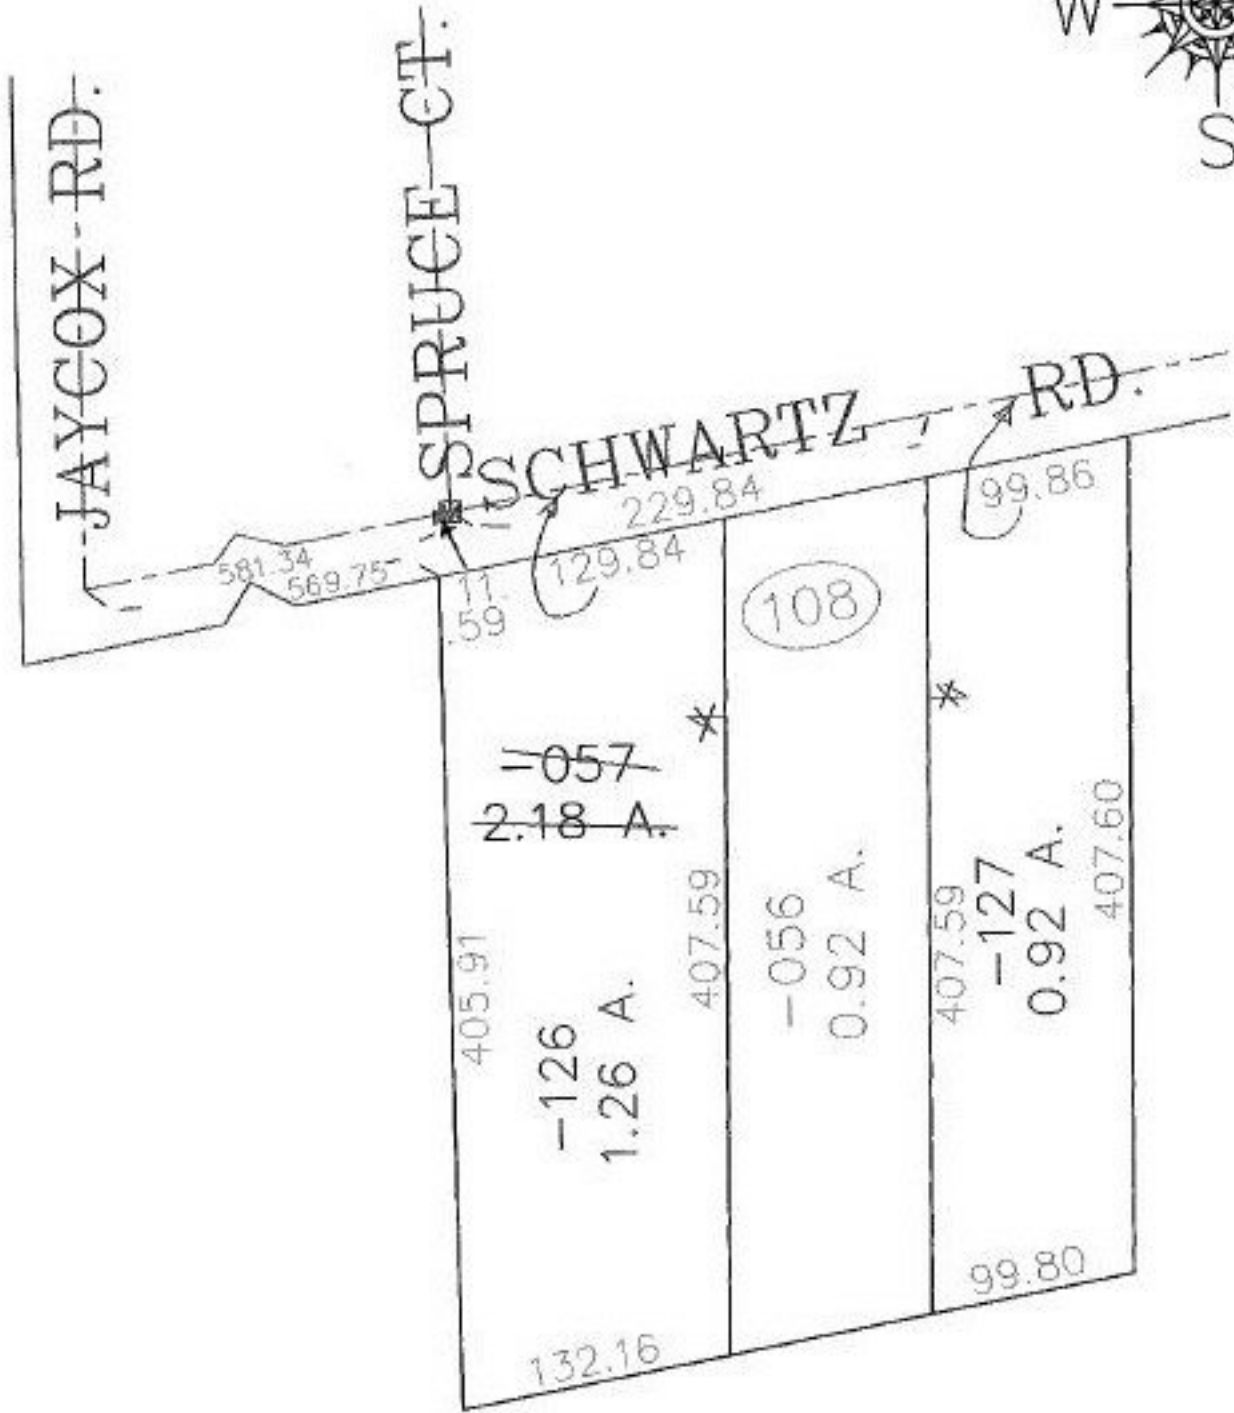

**SPLITS/DEEDS PROCESSED**

LORAIN COUNTY TAX MAP DEPARTMENT  
226 MIDDLE AVE. ELYRIA, OHIO

SURVEYED BY: DANE A. HAPONEK

CLOSURE: 0.02 : 10.000

MAP PAGE(S): 4-00-023-G

APPROVED BY: JAH DATE: 1-3-01

SCALE: 1" = 100' PRIOR INSTRUMENT: 200000716155