


RASTER

NO. 00644

PARENT PARCEL: 09-00-107-000-006

CHILD PARCEL: 09-00-107-000-015 THRU -019

STARTING POINT: CENTERLINE OF HAMILTON ST. & O.L. 107

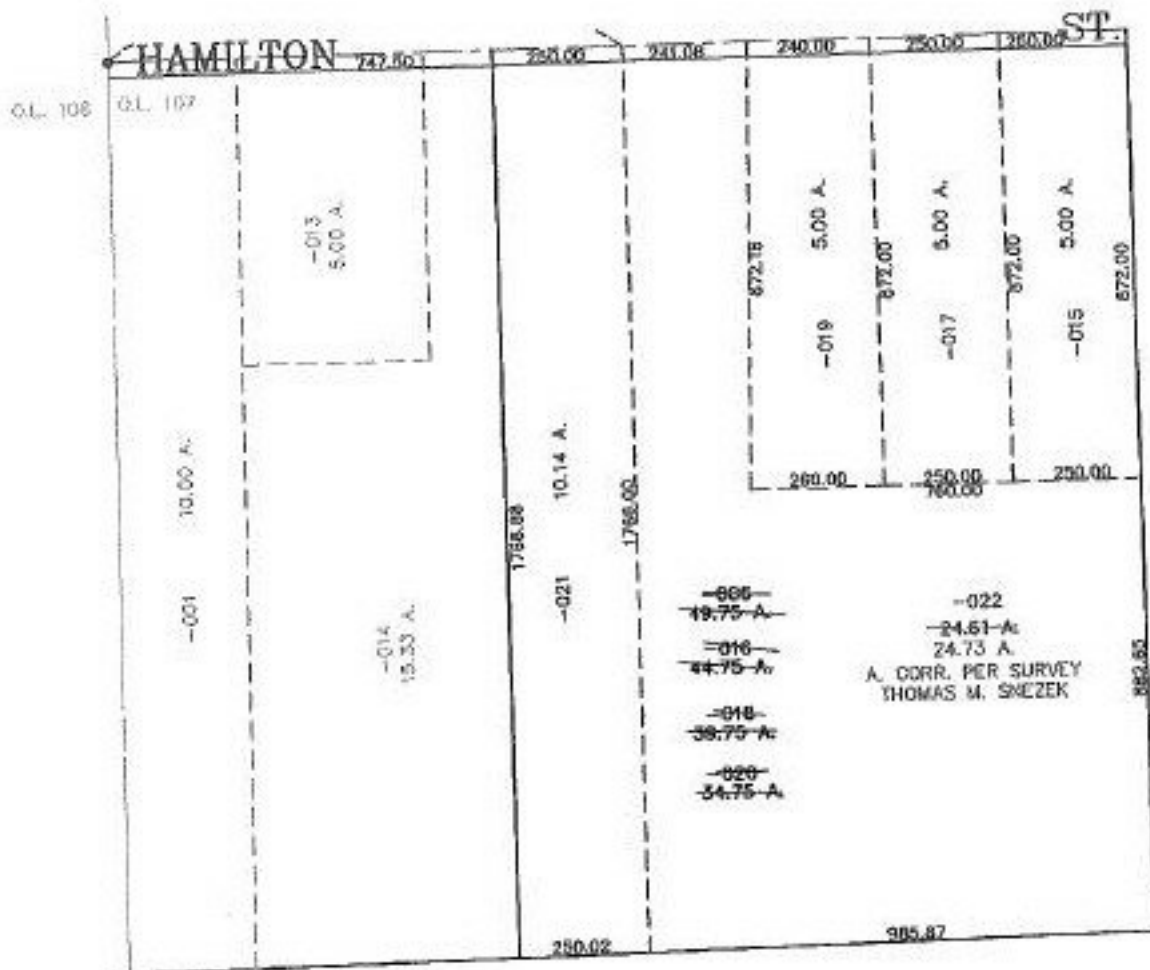

**SPLITS/DEEDS PROCESSED**

LORAIN COUNTY TAX MAP DEPARTMENT  
226 MIDDLE AVE. ELYRIA, OHIO

SURVEYED BY: THOMAS M. SNEZEK

CLOSURE: 0.01 : 10,000

MAP PAGE(S): 9-G

APPROVED BY: JAH DATE: 01/23/01

SCALE: 1" = 400' PRIOR INSTRUMENT: 20000671007