


CASTER

PARENT PARCEL: 15-00-081-000-002
CHILD PARCEL: 15-00-081-000-012, -013
STARTING POINT: CENTERLINE OF NICKEL PLATE DIAGONAL RD. & O.L. 81

NO. 00647

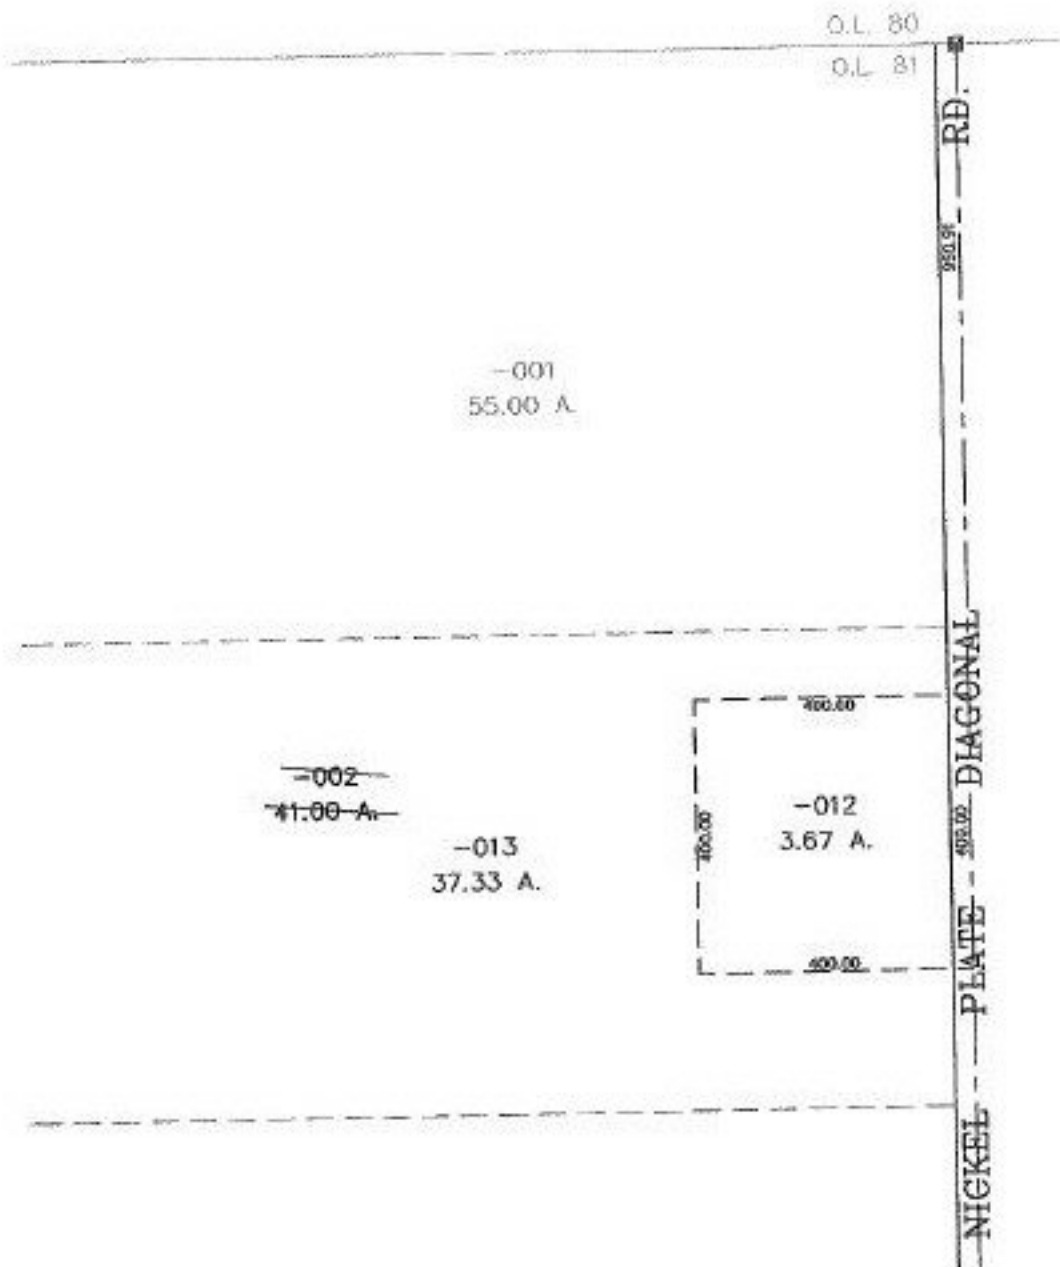

SPLITS/DEEDS PROCESSED
LORAIN COUNTY TAX MAP DEPARTMENT
226 MIDDLE AVE. ELYRIA, OHIO

SURVEYED BY: ALEX KESLER
CLOSURE: 0.00 : 10.000
MAP PAGE(S): 15-F
APPROVED BY: JAH DATE: 01/17/01
SCALE: 1" = 300' PRIOR INSTRUMENT: OR 190/191