
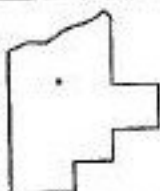


PARENT PARCEL: 10-00-003-112-001, -004, -013
CHILD PARCEL: 10-00-003-112-015 THRU -019
STARTING POINT: CENTERLINE OF WEST RIVER RD. & SUBD. LINE OF FRANK POLEN SUBD.

NO. 00654

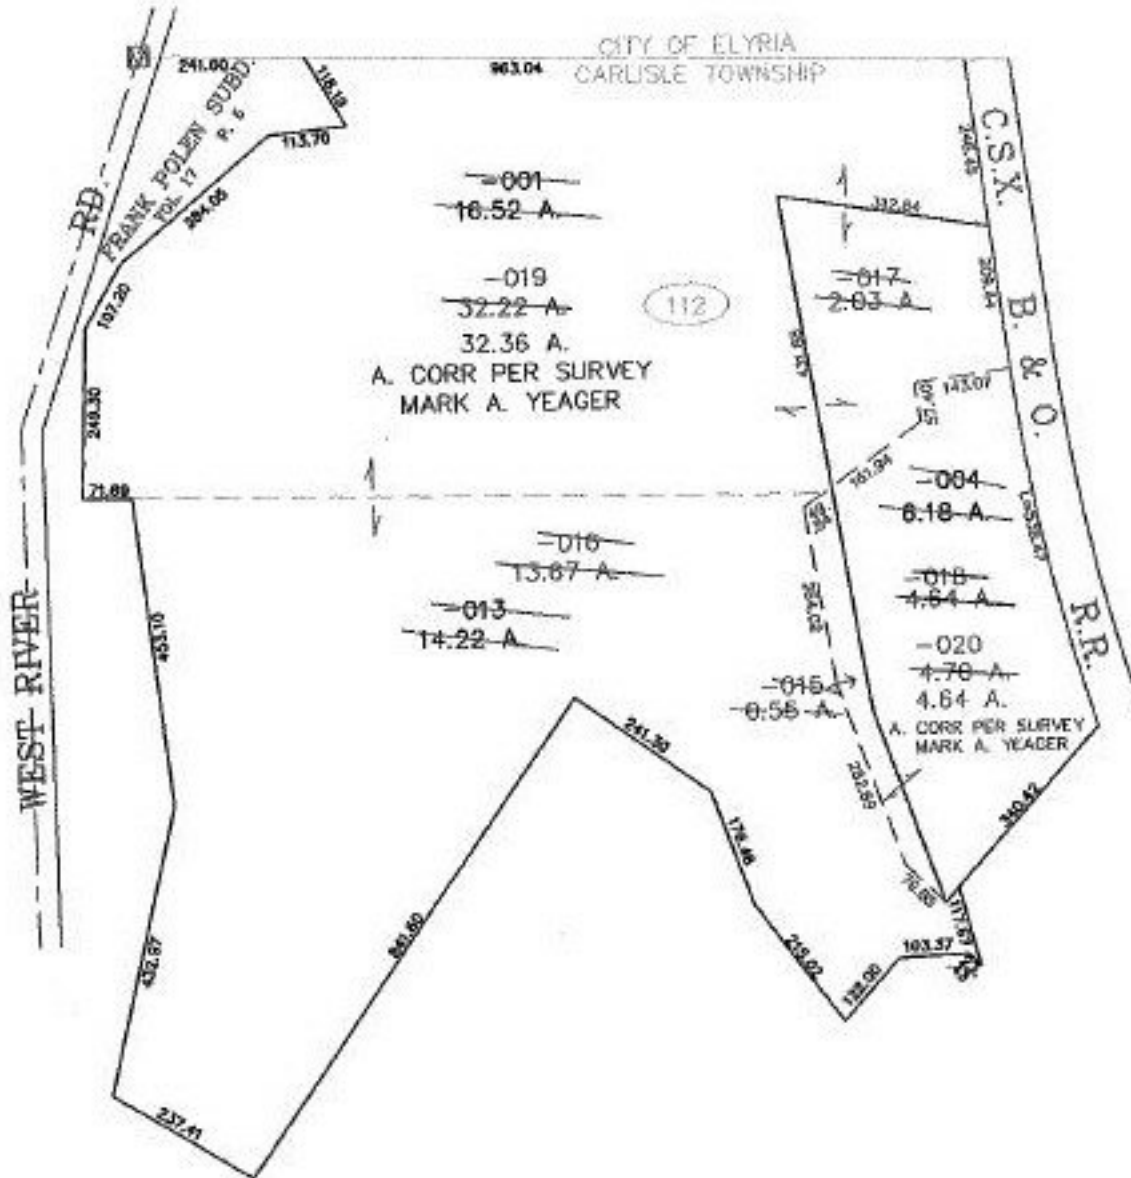

SPLITS/DEEDS PROCESSED
LORAIN COUNTY TAX MAP DEPARTMENT
226 MIDDLE AVE. ELYRIA, OHIO

SURVEYED BY: MARK A. YEAGER
CLOSURE: 0.02 : 10.000
MAP PAGE(S): 10-00-003-B
APPROVED BY: JAH DATE: 1-30-01
SCALE: 1" = 300' PRIOR INSTRUMENT: