
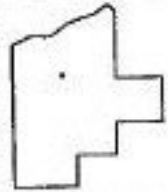


MASTER

PARENT PARCEL: 01-00-041-000-008
CHILD PARCEL: 01-00-041-000-021, -022, -023
STARTING POINT: CENTERLINE OF RICE RD. & O.L. 41

NO. 00655

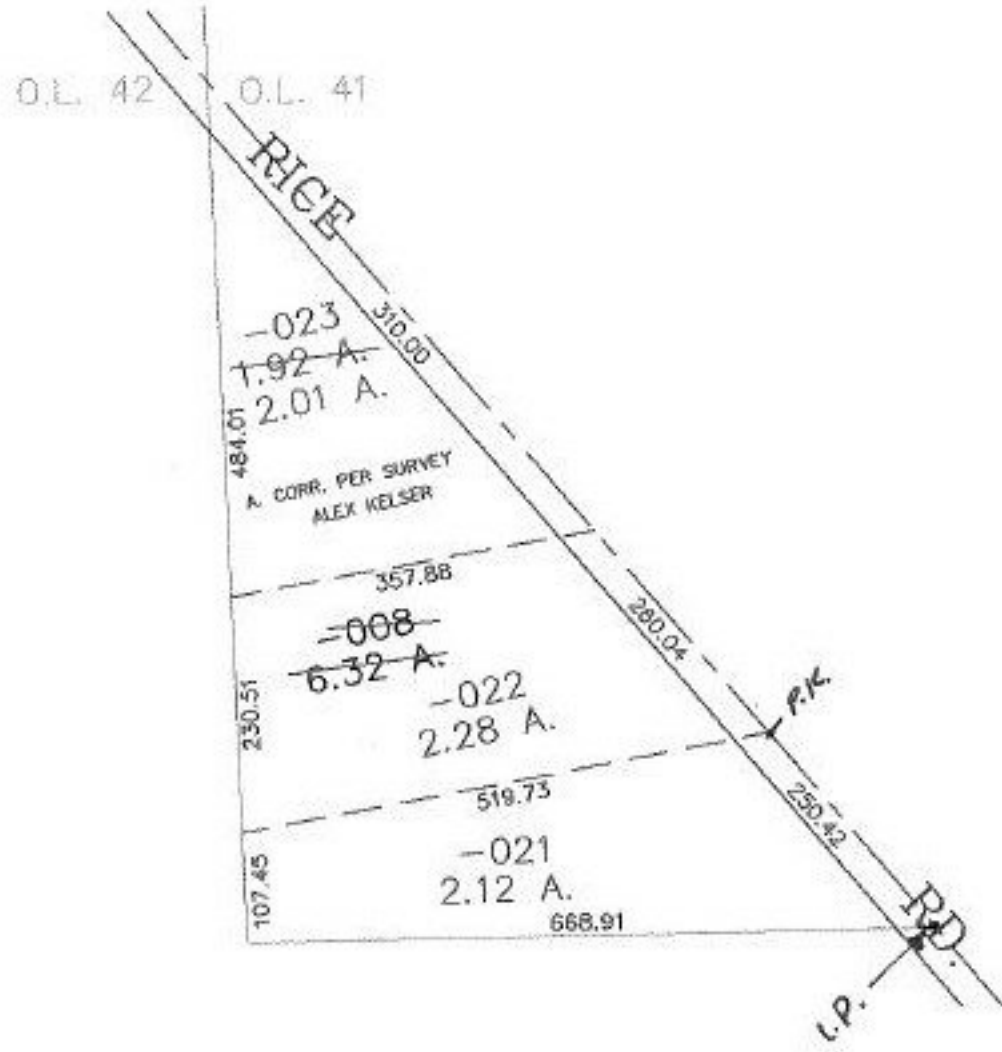

SPLITS/DEEDS PROCESSED
LORAIN COUNTY TAX MAP DEPARTMENT
226 MIDDLE AVE. ELYRIA, OHIO

SURVEYED BY: ALEX KELSER
CLOSURE: 0.01 : 10,000
MAP PAGE(S): 1-II
APPROVED BY: JAH DATE: 02/07/01
SCALE: 1" = 200' PRIOR INSTRUMENT: DV 1410/704