
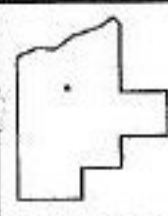


MASTER

PARENT PARCEL: 03-00-001-000-045, -048, -062, -089
CHILD PARCEL: 03-00-001-000-122
STARTING POINT: CENTERLINE OF ABBE RD. & SHEFFIELD TOWNSHIP LOT 1

NO. 00656

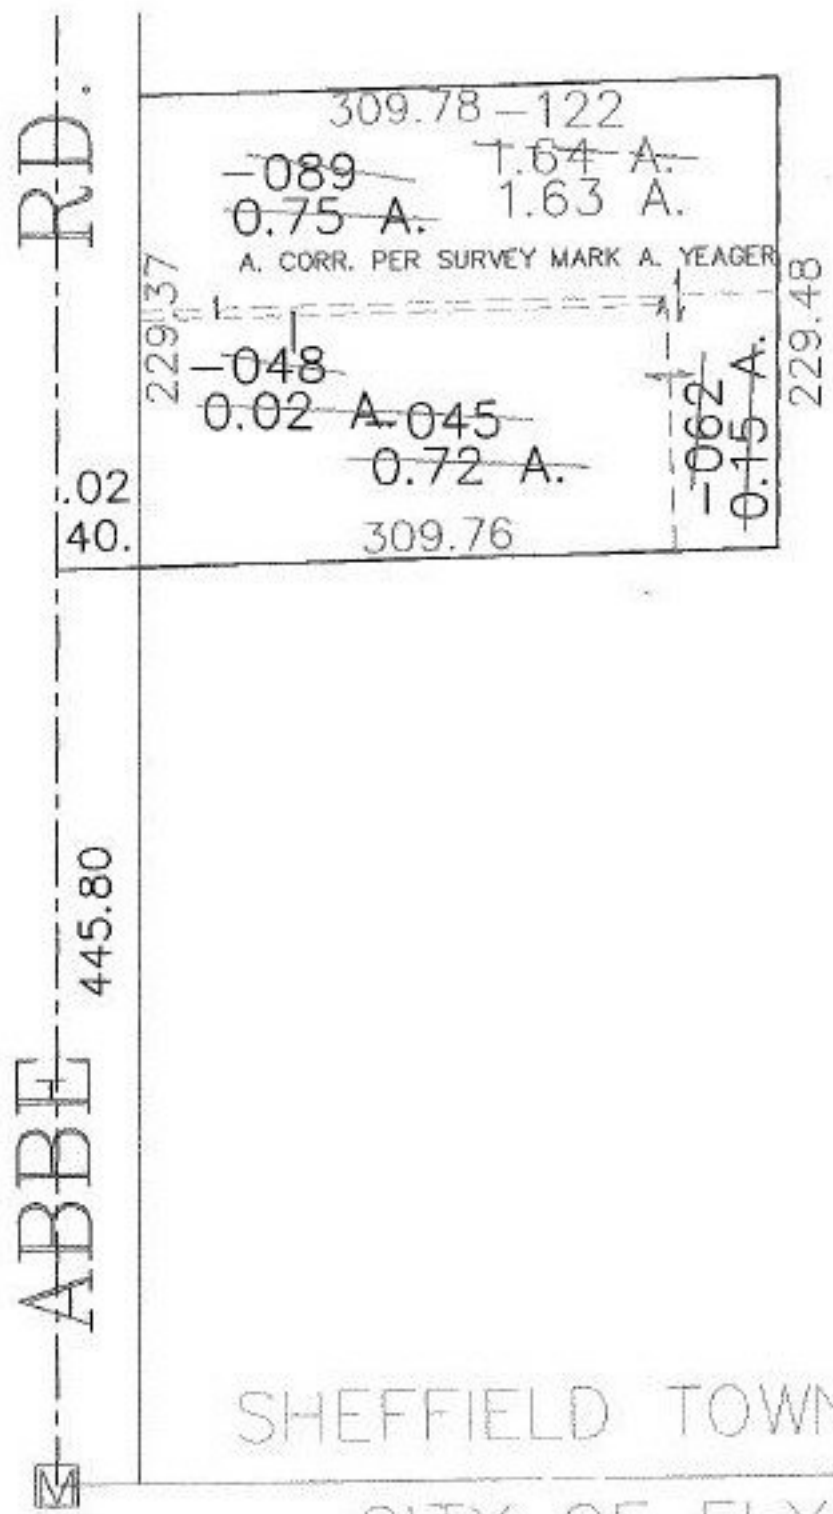

SPLITS/DEEDS PROCESSED

LORAIN COUNTY TAX MAP DEPARTMENT
226 MIDDLE AVE. ELYRIA, OHIO

SURVEYED BY: MARK A. YEAGER
CLOSURE: 0.02 : 10,000
MAP PAGE(S): 03-00-001-A
APPROVED BY: JAH DATE: 1-30-01
SCALE: 1" = 100' PRIOR INSTRUMENT: DY 1279/218