


MASTER

PARENT PARCEL: 04-00-030-142-002

CHILD PARCEL: 04-00-030-142-173, -174

STARTING POINT: SIDELINE OF LAKE RD. & BRUNSWICK DR.

NO. 00672

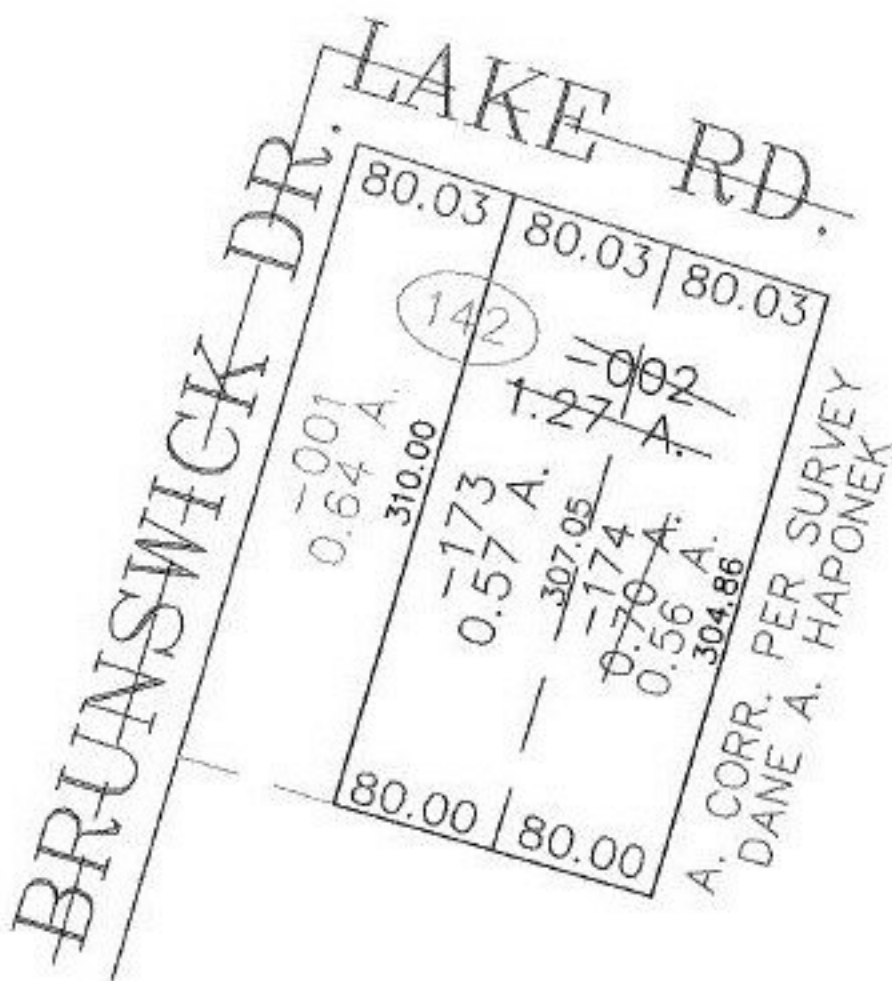

SPLITS/DEEDS PROCESSED

LORAIN COUNTY TAX MAP DEPARTMENT  
226 MIDDLE AVE. ELYRIA, OHIO

SURVEYED BY: DANE A. HAPONEK

CLOSURE: 0.00 : 10.000

MAP PAGE(S): 04-00-030-0

APPROVED BY: JAH DATE: 2-27-01

SCALE: 1" = 100' PRIOR INSTRUMENT: 20000717 103