

EASTER

PARENT PARCEL: 10-00-019-000-050
CHILD PARCEL: 10-00-019-000-112, -113
STARTING POINT: CENTERLINE OF WHITEHEAD RD. & NICKEL-PLATE DIAGONAL RD.

NO. 00673




NICKEL-PLATE-DIAGONAL RD.

127.00


RD

WHITEHEAD

228.73

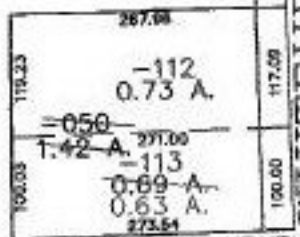

A. CORR. PER SURVEY
RICHARD D. CARLSON

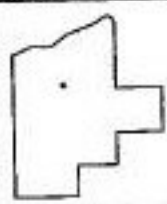

SPLITS/DEEDS PROCESSED
LORAIN COUNTY TAX MAP DEPARTMENT
226 MIDDLE AVE. ELYRIA, OHIO

SURVEYED BY: RICHARD D. CARLSON
CLOSURE: 0.00 : 10.000
MAP PAGE(S): 10-F
APPROVED BY: JAH DATE: 2-27-01
SCALE: 1" = 200' PRIOR INSTRUMENT: 20000698511