
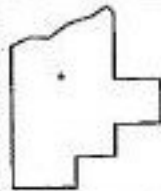


PASTER

PARENT PARCEL: 09-00-012-000-038, -035
CHILD PARCEL: 09-00-012-000-039 THRU -041
STARTING POINT: CENTERLINE OF QUARRY RD. & RUSSIA RD.

NO. 00677

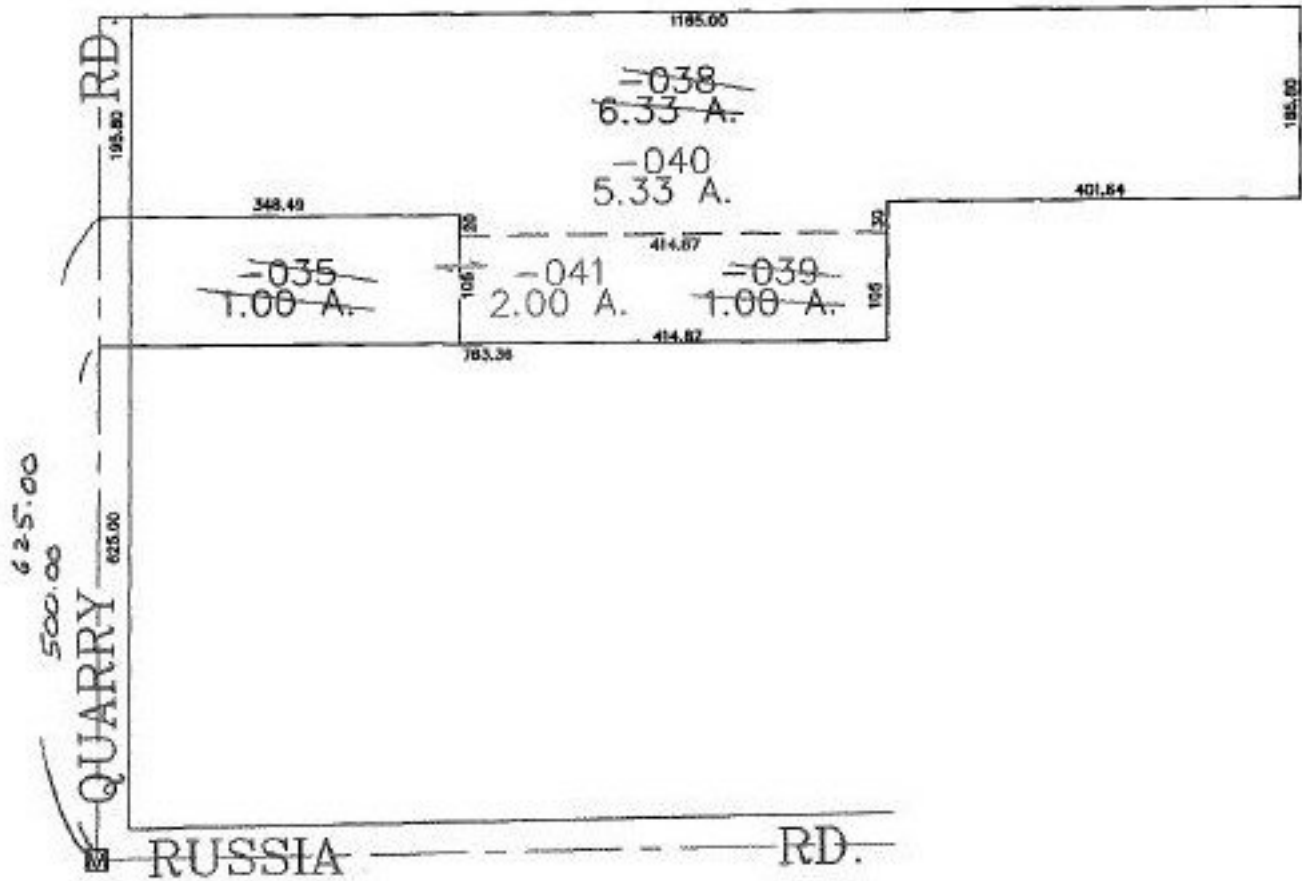

SPLITS/DEEDS PROCESSED
LORAIN COUNTY TAX MAP DEPARTMENT
226 MIDDLE AVE. ELYRIA, OHIO

SURVEYED BY: JAMES P. YURKSCHATT
CLOSURE: 0.01 : 10.000
MAP PAGE(S): 9-00-012-A
APPROVED BY: JAH DATE: 3-1-01
SCALE: 1" = 200' PRIOR INSTRUMENT: DV 1415/720