
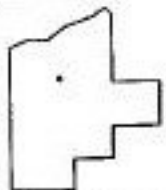


PARENT PARCEL: 01-00-026-000-048

CHILD PARCEL: 01-00-026-000-049, -050

STARTING POINT: CENTERLINE OF WHITTLESEY RD. & BAUMHART RD.

NO. 00678

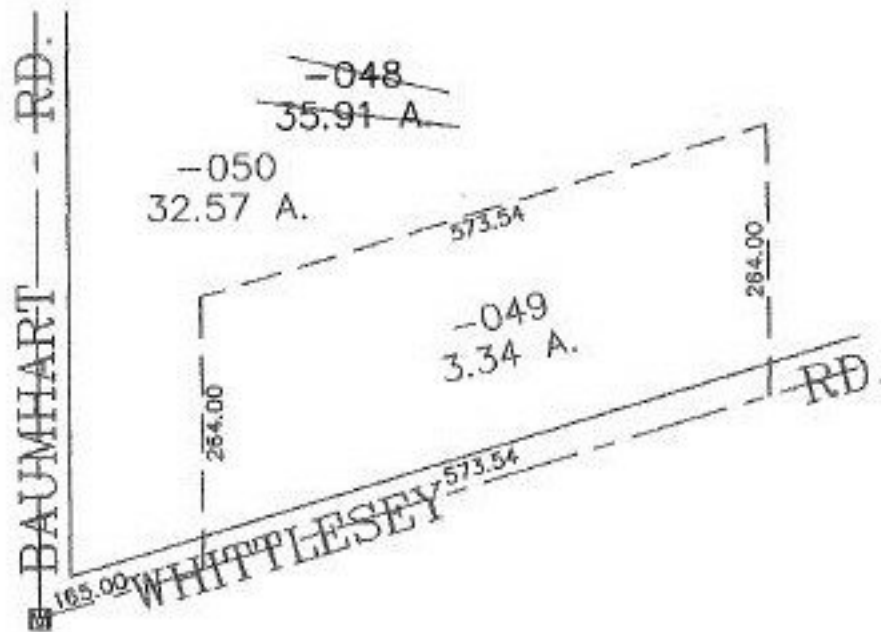

**SPLITS/DEEDS PROCESSED**

LORAIN COUNTY TAX MAP DEPARTMENT  
226 MIDDLE AVE. ELYRIA, OHIO

SURVEYED BY: THOMAS M. SNEZEK

CLOSURE: 0.00 : 10.000

MAP PAGE(S): 1-00-026-A

APPROVED BY: JAH DATE: 3-2-01

SCALE: 1" = 200' PRIOR INSTRUMENT: 20000667960