


MASTER

PARENT PARCEL: 11-00-017-000-021
CHILD PARCEL: 11-00-017-000-038, -039
STARTING POINT: CENTERLINE OF COWLEY RD. & CAPEL RD.

NO. 00681

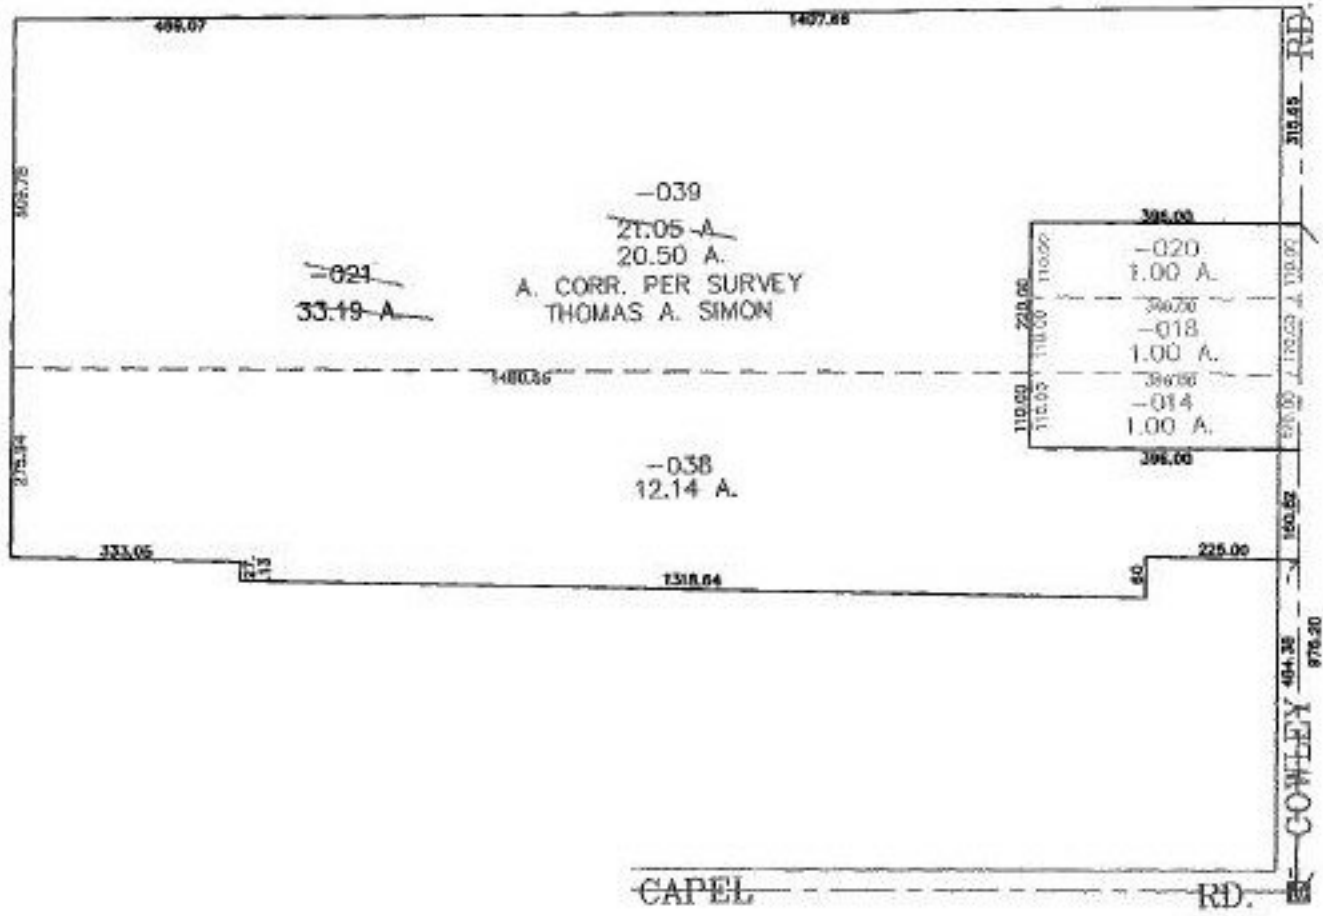

SPLITS/DEEDS PROCESSED
LORAIN COUNTY TAX MAP DEPARTMENT
226 MIDDLE AVE. ELYRIA, OHIO

SURVEYED BY: THOMAS A. SIMON
CLOSURE: 0.01 : 10.000
MAP PAGE(S): 11-H
APPROVED BY: JAH DATE: 02-05-01
SCALE: 1" = 300' PRIOR INSTRUMENT: OR 1243/79