



EASTER

PARENT PARCEL: 14-00-009-000-018

CHILD PARCEL: 14-00-009-000-019 thru -021

STARTING POINT: CENTERLINE OF QUARRY RD. & O.L. 9 & 12

NO. 00682

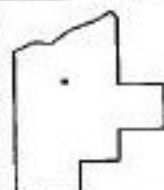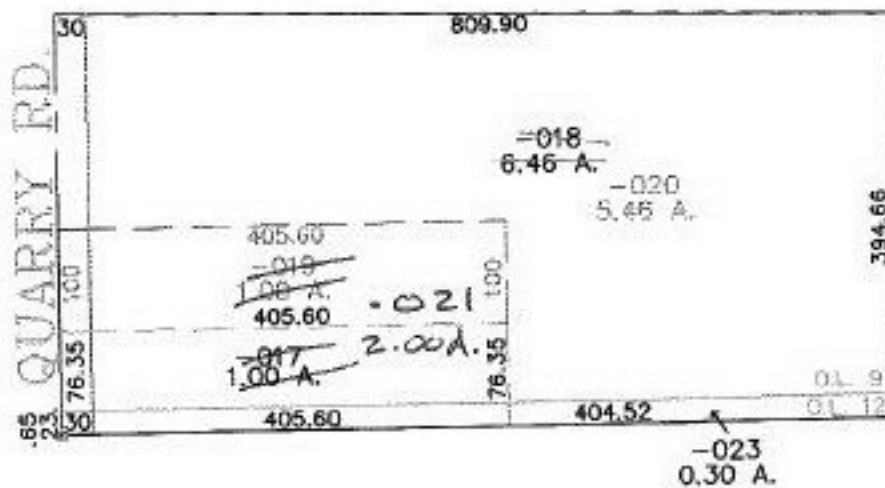

SPLITS/DEEDS PROCESSED
 LORAIN COUNTY TAX MAP DEPARTMENT
 226 MIDDLE AVE. ELYRIA, OHIO

SURVEYED BY: PATRICK A. MCGANNON
 CLOSURE: 0.00 : 10.000
 MAP PAGE(S): 14-A
 APPROVED BY: JAH DATE: 3-9-01
 SCALE: 1" = 200' PRIOR INSTRUMENT: _____