



MASTER

PARENT PARCEL: 05-00-051-000-004

CHILD PARCEL: 05-00-051-000-012, -013

STARTING POINT: CENTERLINE OF OBERLIN RD. & ALBRECHT RD.

NO. 00686

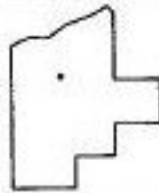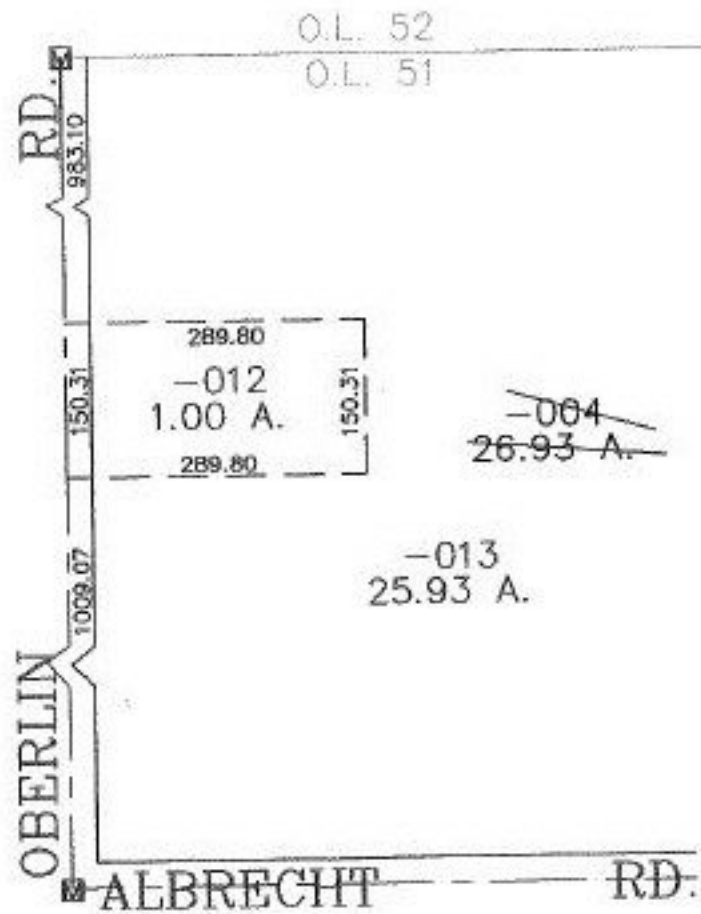

SPLITS/DEEDS PROCESSED
 LORAIN COUNTY TAX MAP DEPARTMENT
 226 MIDDLE AVE. ELYRIA, OHIO

SURVEYED BY: PHILIP A. ROSEBECK
 CLOSURE: 0.00 : 10,000
 MAP PAGE(S): 5-G
 APPROVED BY: JAH DATE: 3-12-01
 SCALE: 1" = 200' PRIOR INSTRUMENT: DV 1016/228