



RASTER

PARENT PARCEL: 01-00-010-000-015

CHILD PARCEL: 01-00-010-000-025 & -026

STARTING POINT: N.E. CORNER OF DEER TRAIL LN.

NO. 00694

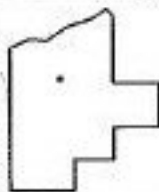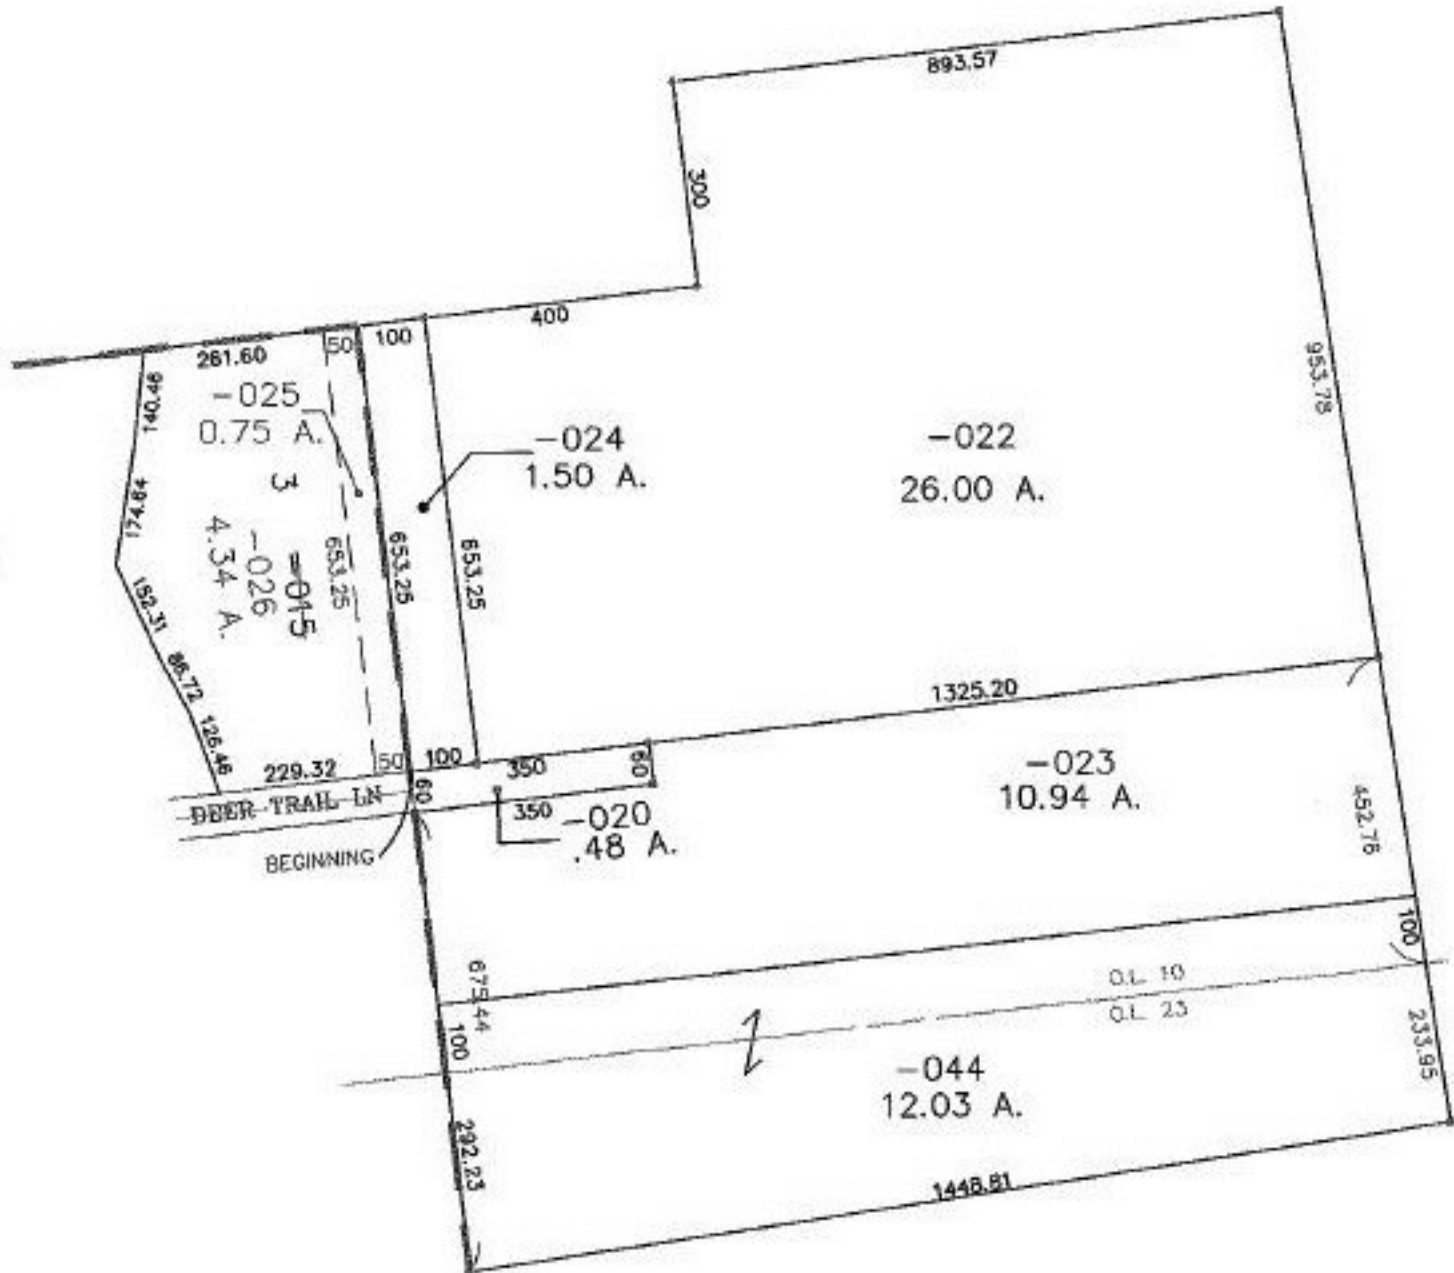

**SPLITS/DEEDS PROCESSED**  
**LORAIN COUNTY TAX MAP DEPARTMENT**  
 226 MIDDLE AVE. ELYRIA, OHIO

SURVEYED BY: M.G. HURA  
 CLOSURE: 0.01 : 10,000  
 MAP PAGE(S): 1-D  
 APPROVED BY: TJS DATE: 4/9/01  
 SCALE: 1" = 300' PRIOR INSTRUMENT: PLAT 58 PG. 77