
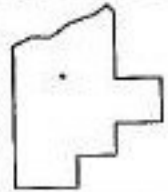


EASTER

NO. 00697

PARENT PARCEL: 20-05-004-000-003  
CHILD PARCEL: 20-05-004-000-015 & -016  
STARTING POINT: CENTERLINE OF QUARRY RD. & O.L. 4

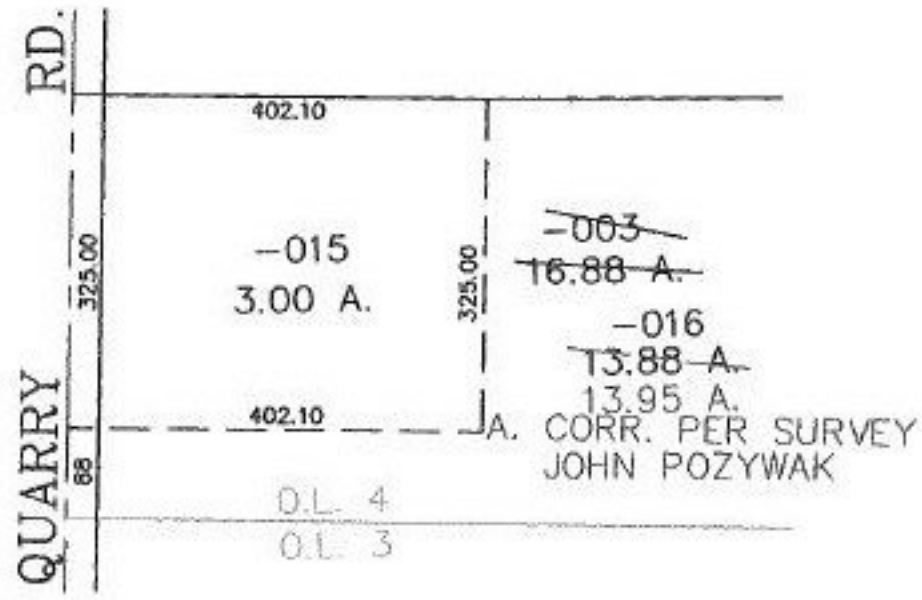

**SPLITS/DEEDS PROCESSED**  
LORAIN COUNTY TAX MAP DEPARTMENT  
226 MIDDLE AVE. ELYRIA, OHIO

SURVEYED BY: JOHN POZYWAK  
CLOSURE: 0.00 : 10.000  
MAP PAGE(S): 20-D  
APPROVED BY: JAH DATE: 3-27-01  
SCALE: 1" = 200' PRIOR INSTRUMENT: DV 1367/31