



MASTER

PARENT PARCEL: 06-24-003-103-045, -046, -047

CHILD PARCEL: 06-24-003-103-075

STARTING POINT: CENTERLINE OF FOWL RD. & WEST RIDGE RD.

NO. 00698

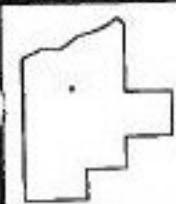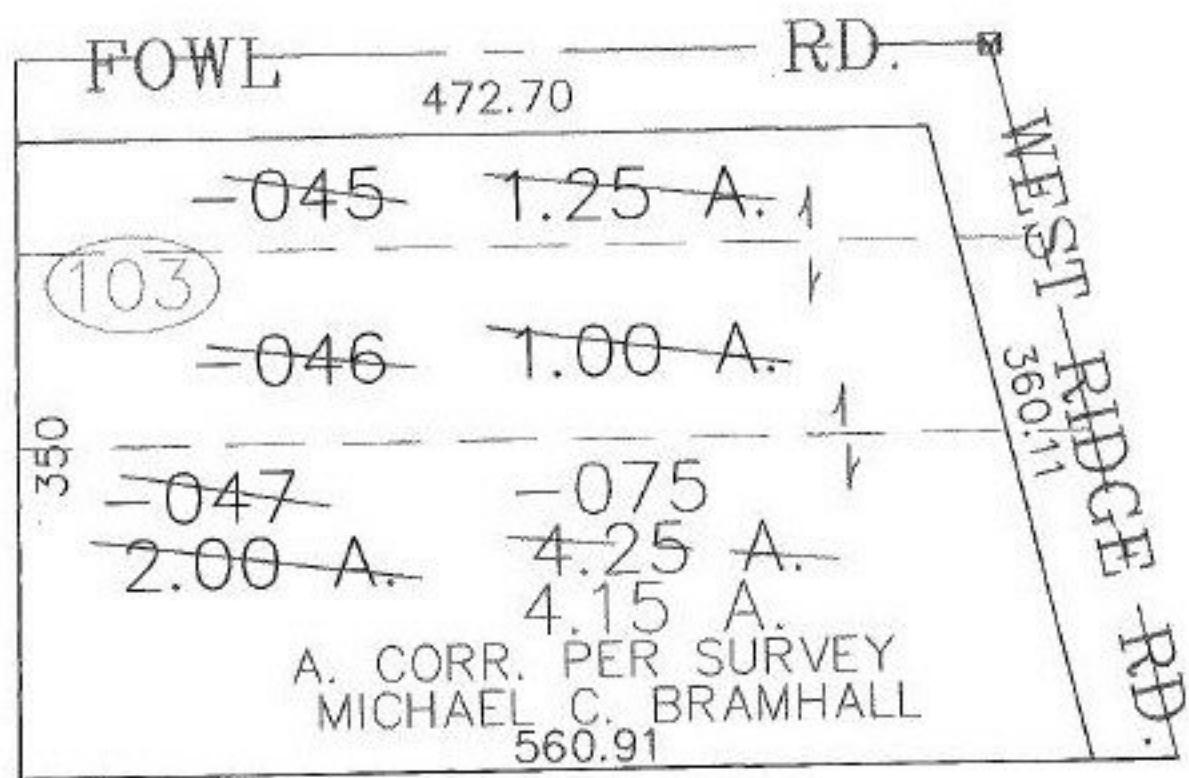

**SPLITS/DEEDS PROCESSED**

LORAIN COUNTY TAX MAP DEPARTMENT  
226 MIDDLE AVE. ELYRIA, OHIO

SURVEYED BY: MICHAEL C. BRAMHALL

CLOSURE: 0.01 : 10.000

MAP PAGE(S): 6-109

APPROVED BY: JAH DATE: 3-23-01

SCALE: 1" = 100 PRIOR INSTRUMENT: 20000692906