


PARENT PARCEL: 02-02-008-107-006



CHILD PARCEL: 02-02-008-107-073, -074

STARTING POINT: INTERSECTION OF C/L OF JAEGER RD. AND WEST LINE OF O.L.8

17-00758

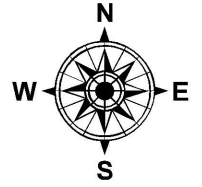

EGER

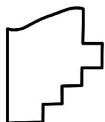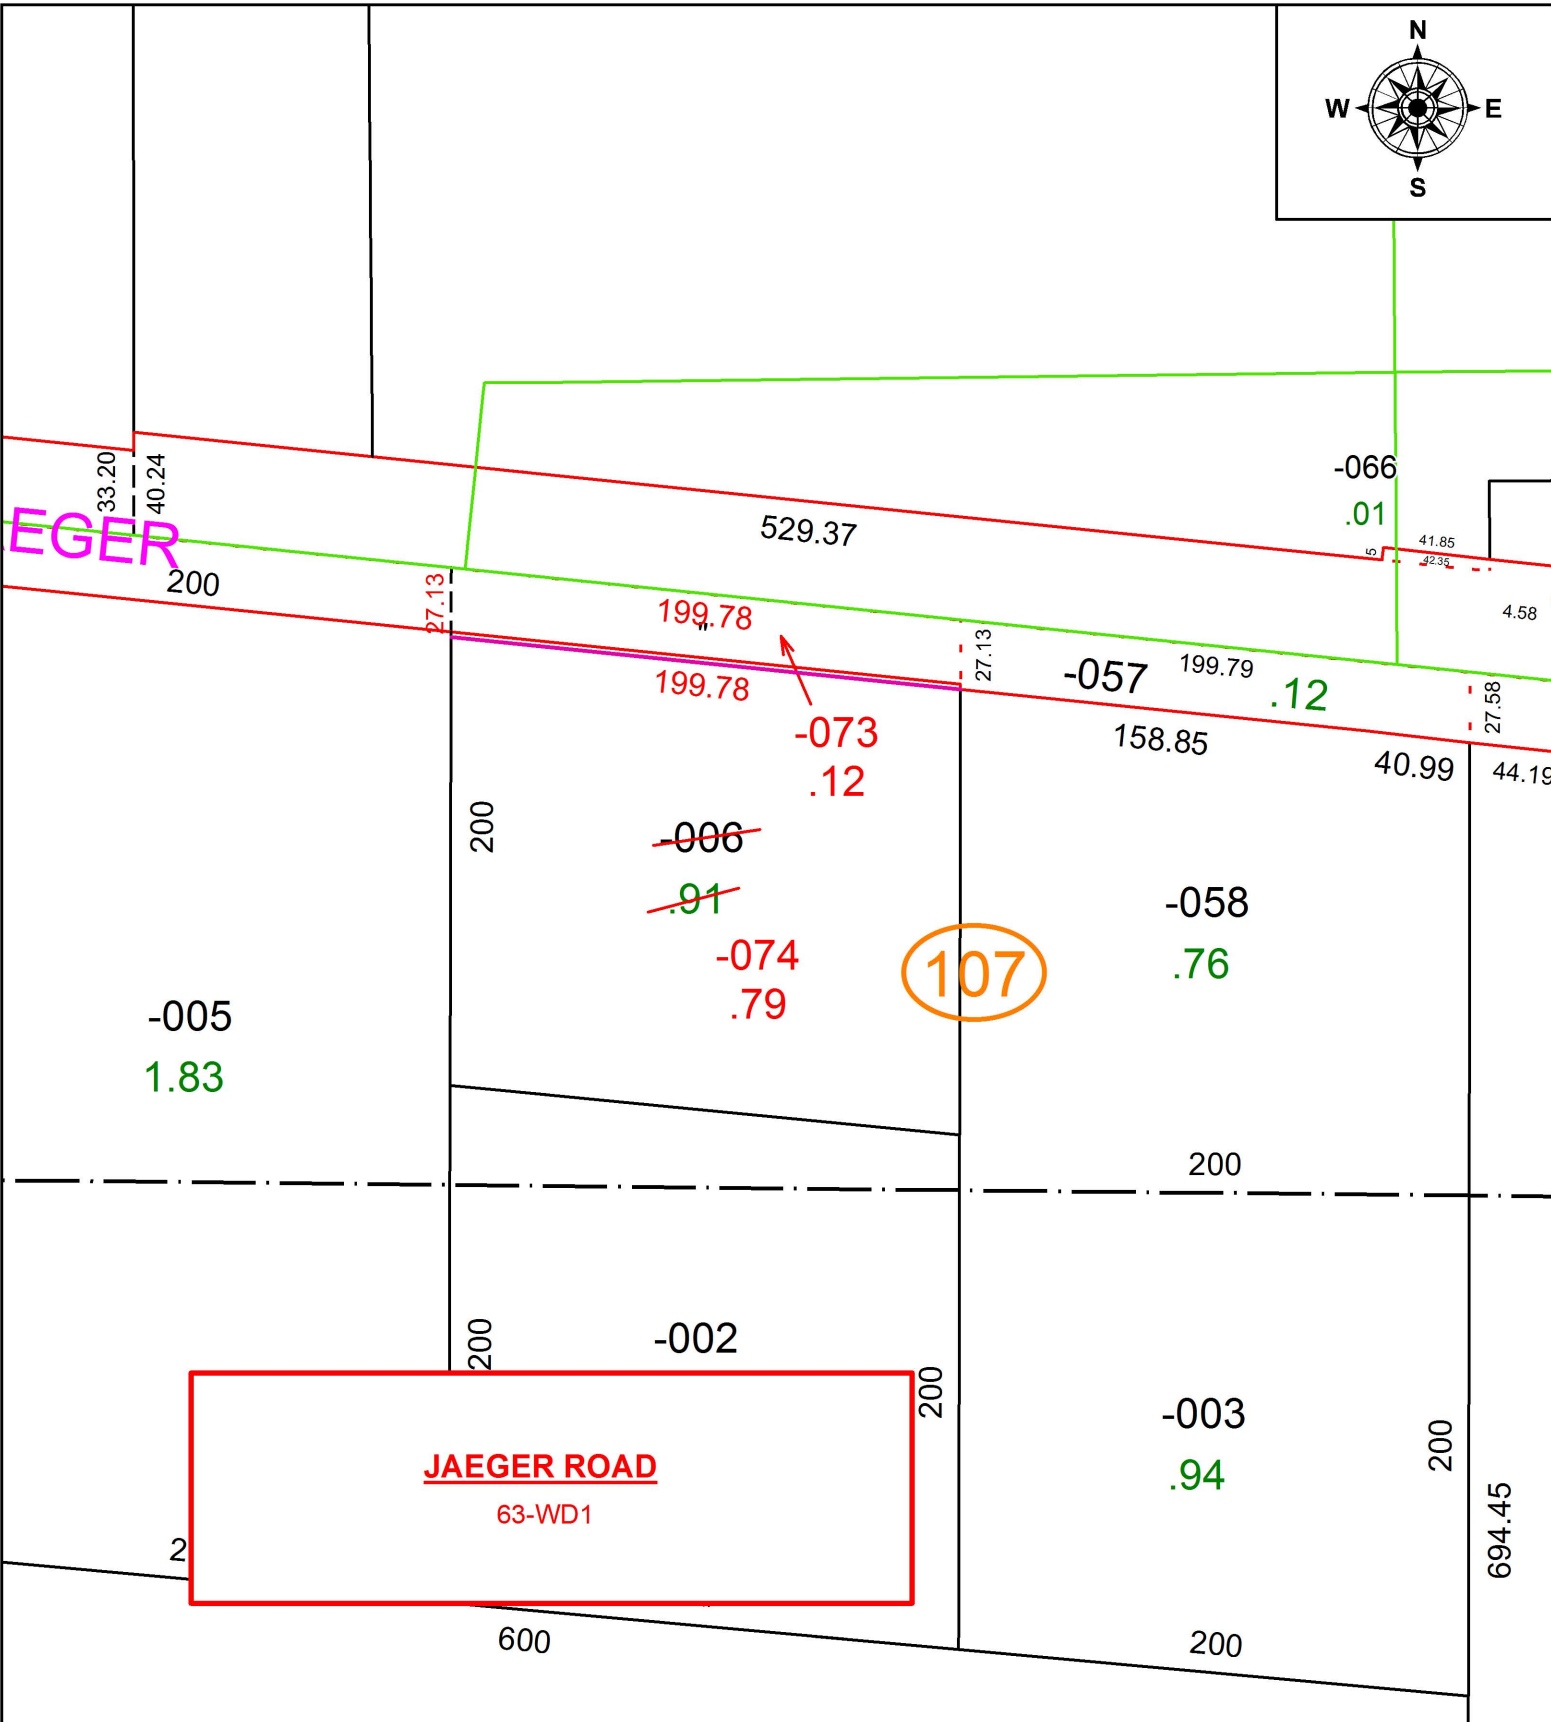

SPLITS/DEEDS PROCESSED
LORAIN COUNTY TAX MAP DEPARTMENT
226 MIDDLE AVE. ELYRIA, OH

SURVEYED BY: TREVOR A. BIXLER
CLOSURE: 1: 2147483648
MAP PAGE(S): 2-02-008
APPROVED BY: RRM DATE: 7-13-17
SCALE: 1" = 75' PRIOR INSTRUMENT: DV 1244/622