


PARENT PARCEL: 07-00-031-000-177

CHILD PARCEL: 07-00-031-000-350 & -351

STARTING POINT: CL OF STONEY RIDGE RD. & CORP. LINE OF CITY OF AVON & N. RIDGEVILLE

22-00782

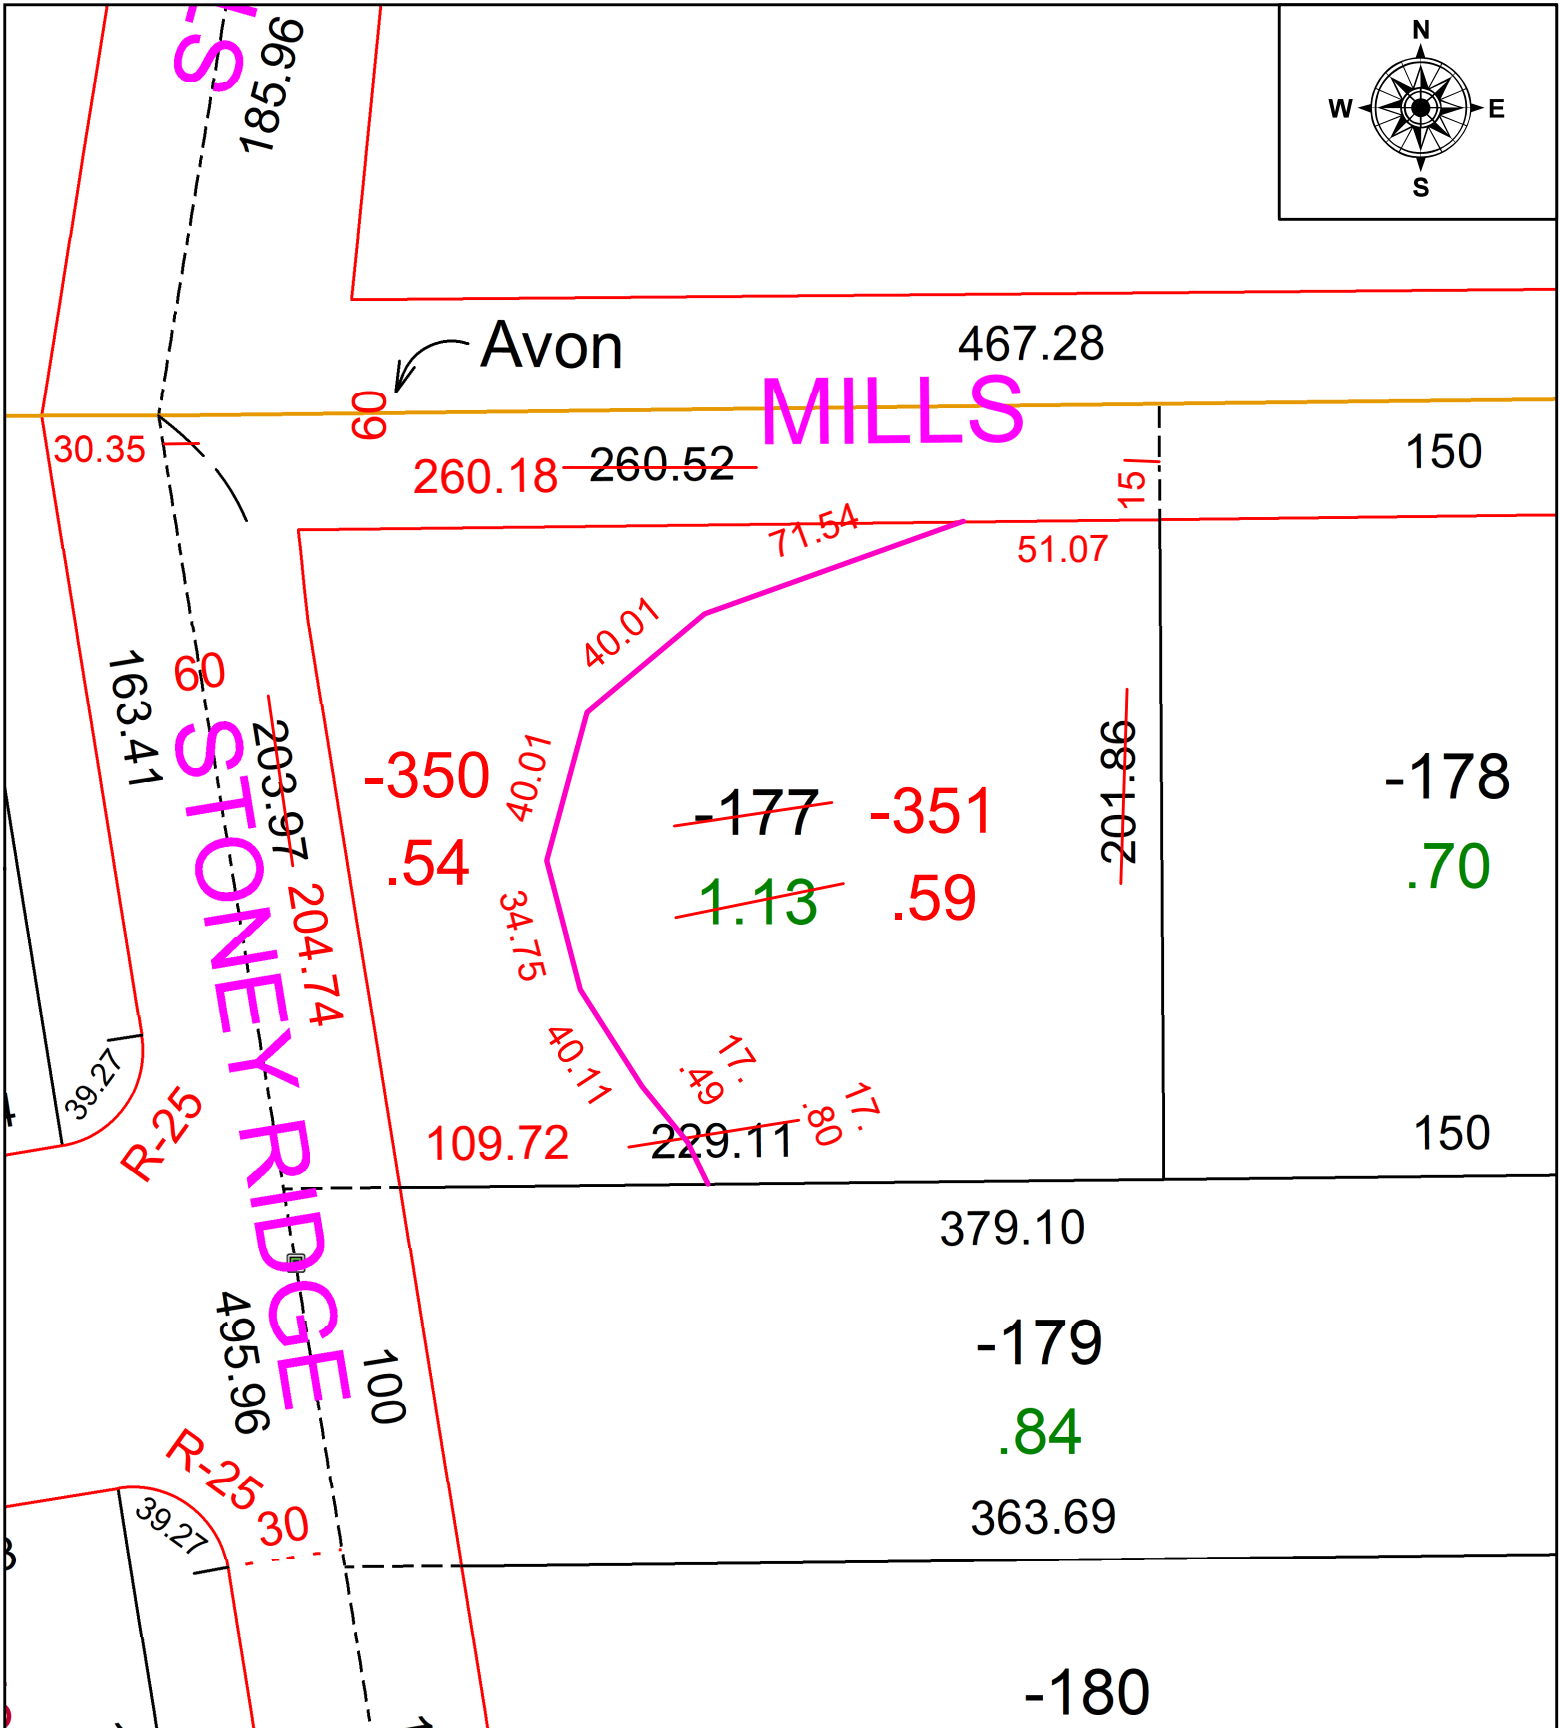

SPLITS/DEEDS PROCESSED
 LORAIN COUNTY TAX MAP DEPARTMENT
 226 MIDDLE AVE. ELYRIA, OH

SURVEYED BY: BRIAN BINGHAM
 CLOSURE: 1:79438
 MAP PAGE(S): 07-00-031
 APPROVED BY: DMA DATE: 6/28/2022
 SCALE: 1" = 50' PRIOR INSTRUMENT: 2017-0655722