
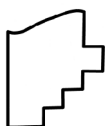
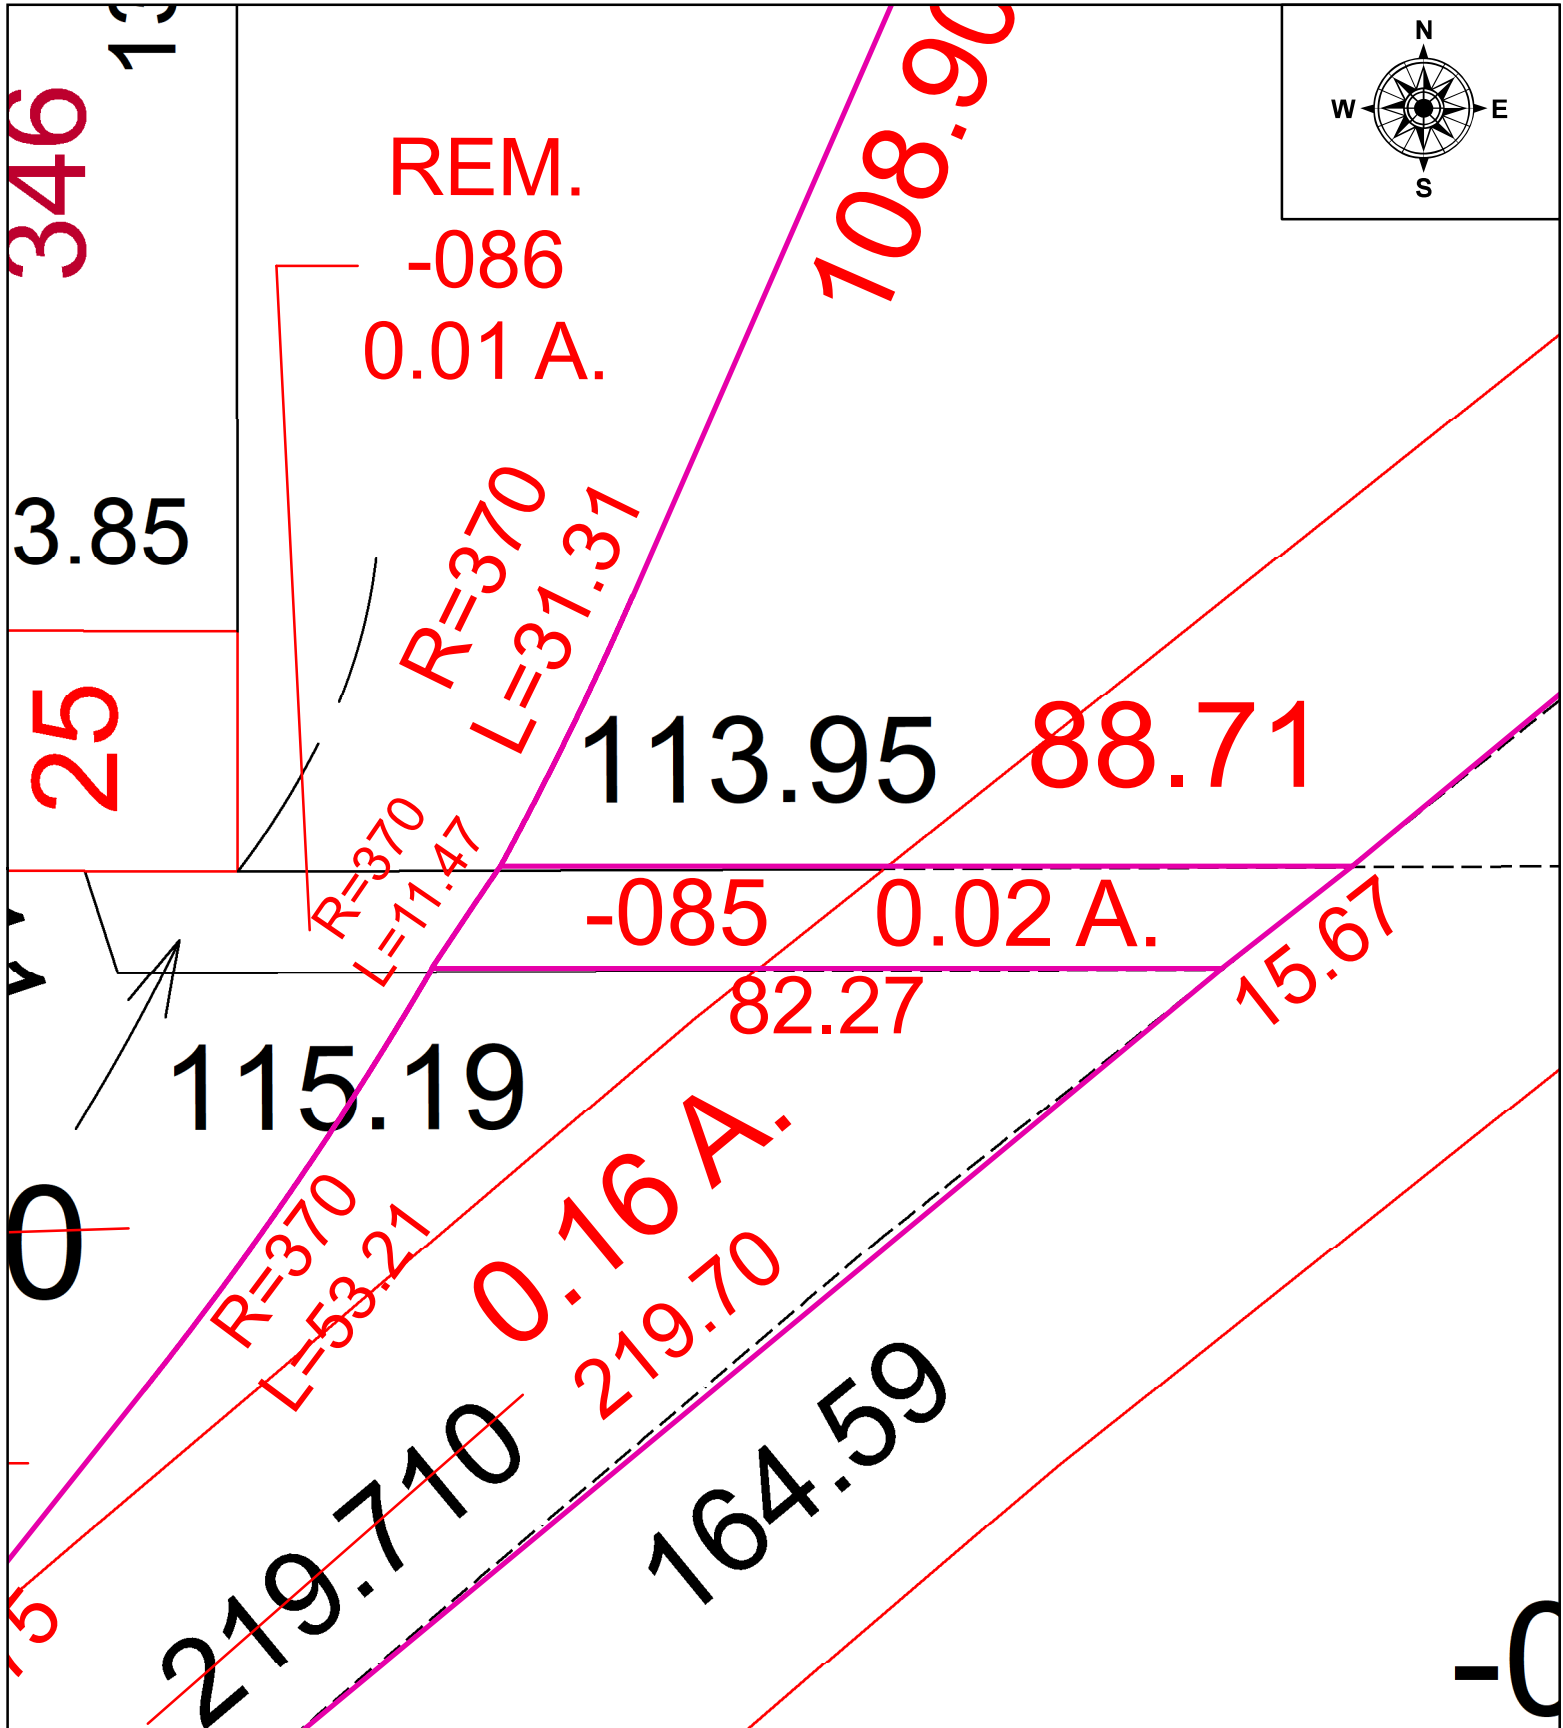


PARENT PARCEL: 07-00-025-101-020

CHILD PARCEL: 07-00-025-101-085 & -086

STARTING POINT: I.P. MON. BOX, CL OF AVON-BELDEN RD. (S.R. 83) & CL OF CHESTNUT RIDGE RD.

22-00787

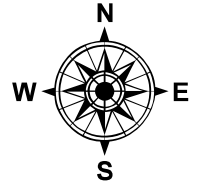

**SPLITS/DEEDS PROCESSED**  
 LORAIN COUNTY TAX MAP DEPARTMENT  
 226 MIDDLE AVE. ELYRIA, OH

SURVEYED BY: MICHAEL J. WARD

CLOSURE: 1:40765

MAP PAGE(S): 07-00-025

APPROVED BY: TJS DATE: 10/13/2022

SCALE: 1" = 20' PRIOR INSTRUMENT: 1998-0549101