
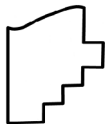
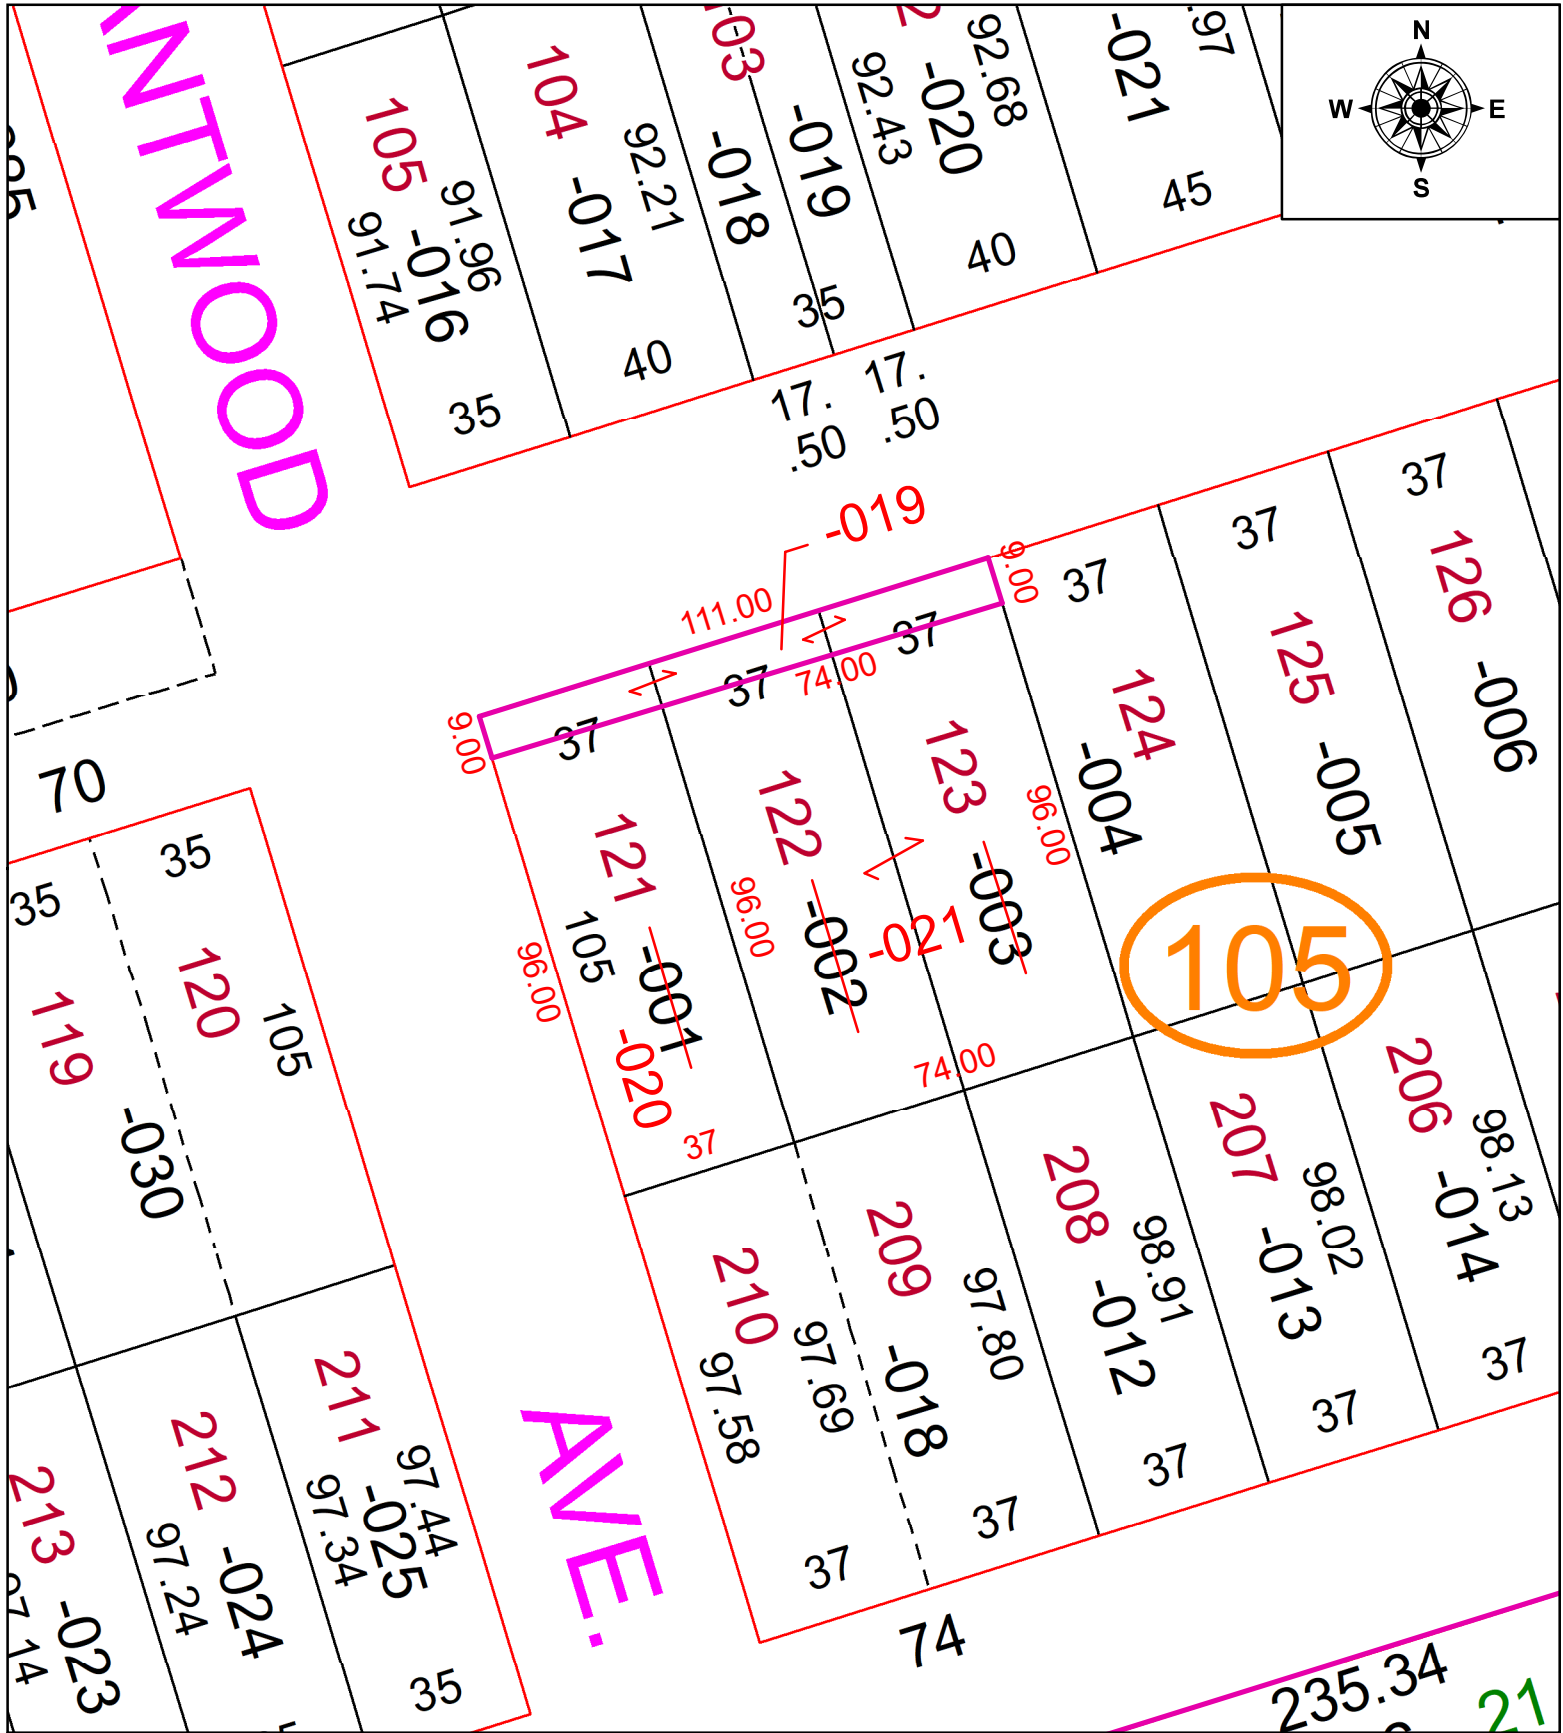


PARENT PARCEL: 03-00-040-105-001 THRU -003

CHILD PARCEL: 03-00-004-105-019 THRU -021

STARTING POINT: MAG. NAIL SET, CL OF LAKE RD. & CL OF GRANTWOOD AVE.

24-00796

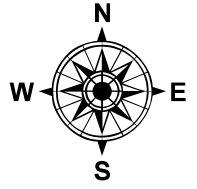

SPLITS/DEEDS PROCESSED
LORAIN COUNTY TAX MAP DEPARTMENT
226 MIDDLE AVE. ELYRIA, OH

SURVEYED BY: AMY KELLY
CLOSURE: 1: INF
MAP PAGE(S): 03-00-040
APPROVED BY: TJS DATE: 9/26/2024
SCALE: 1" = 40' PRIOR INSTRUMENT: 2022-0887613