


PARENT PARCEL: 03-00-040-105-007 THRU -009

CHILD PARCEL: 03-00-040-105-022 THRU -025

STARTING POINT: MAG. NAIL SET, CL OF LAKE RD. & CL OF GRANTWOOD AVE.

24-00797

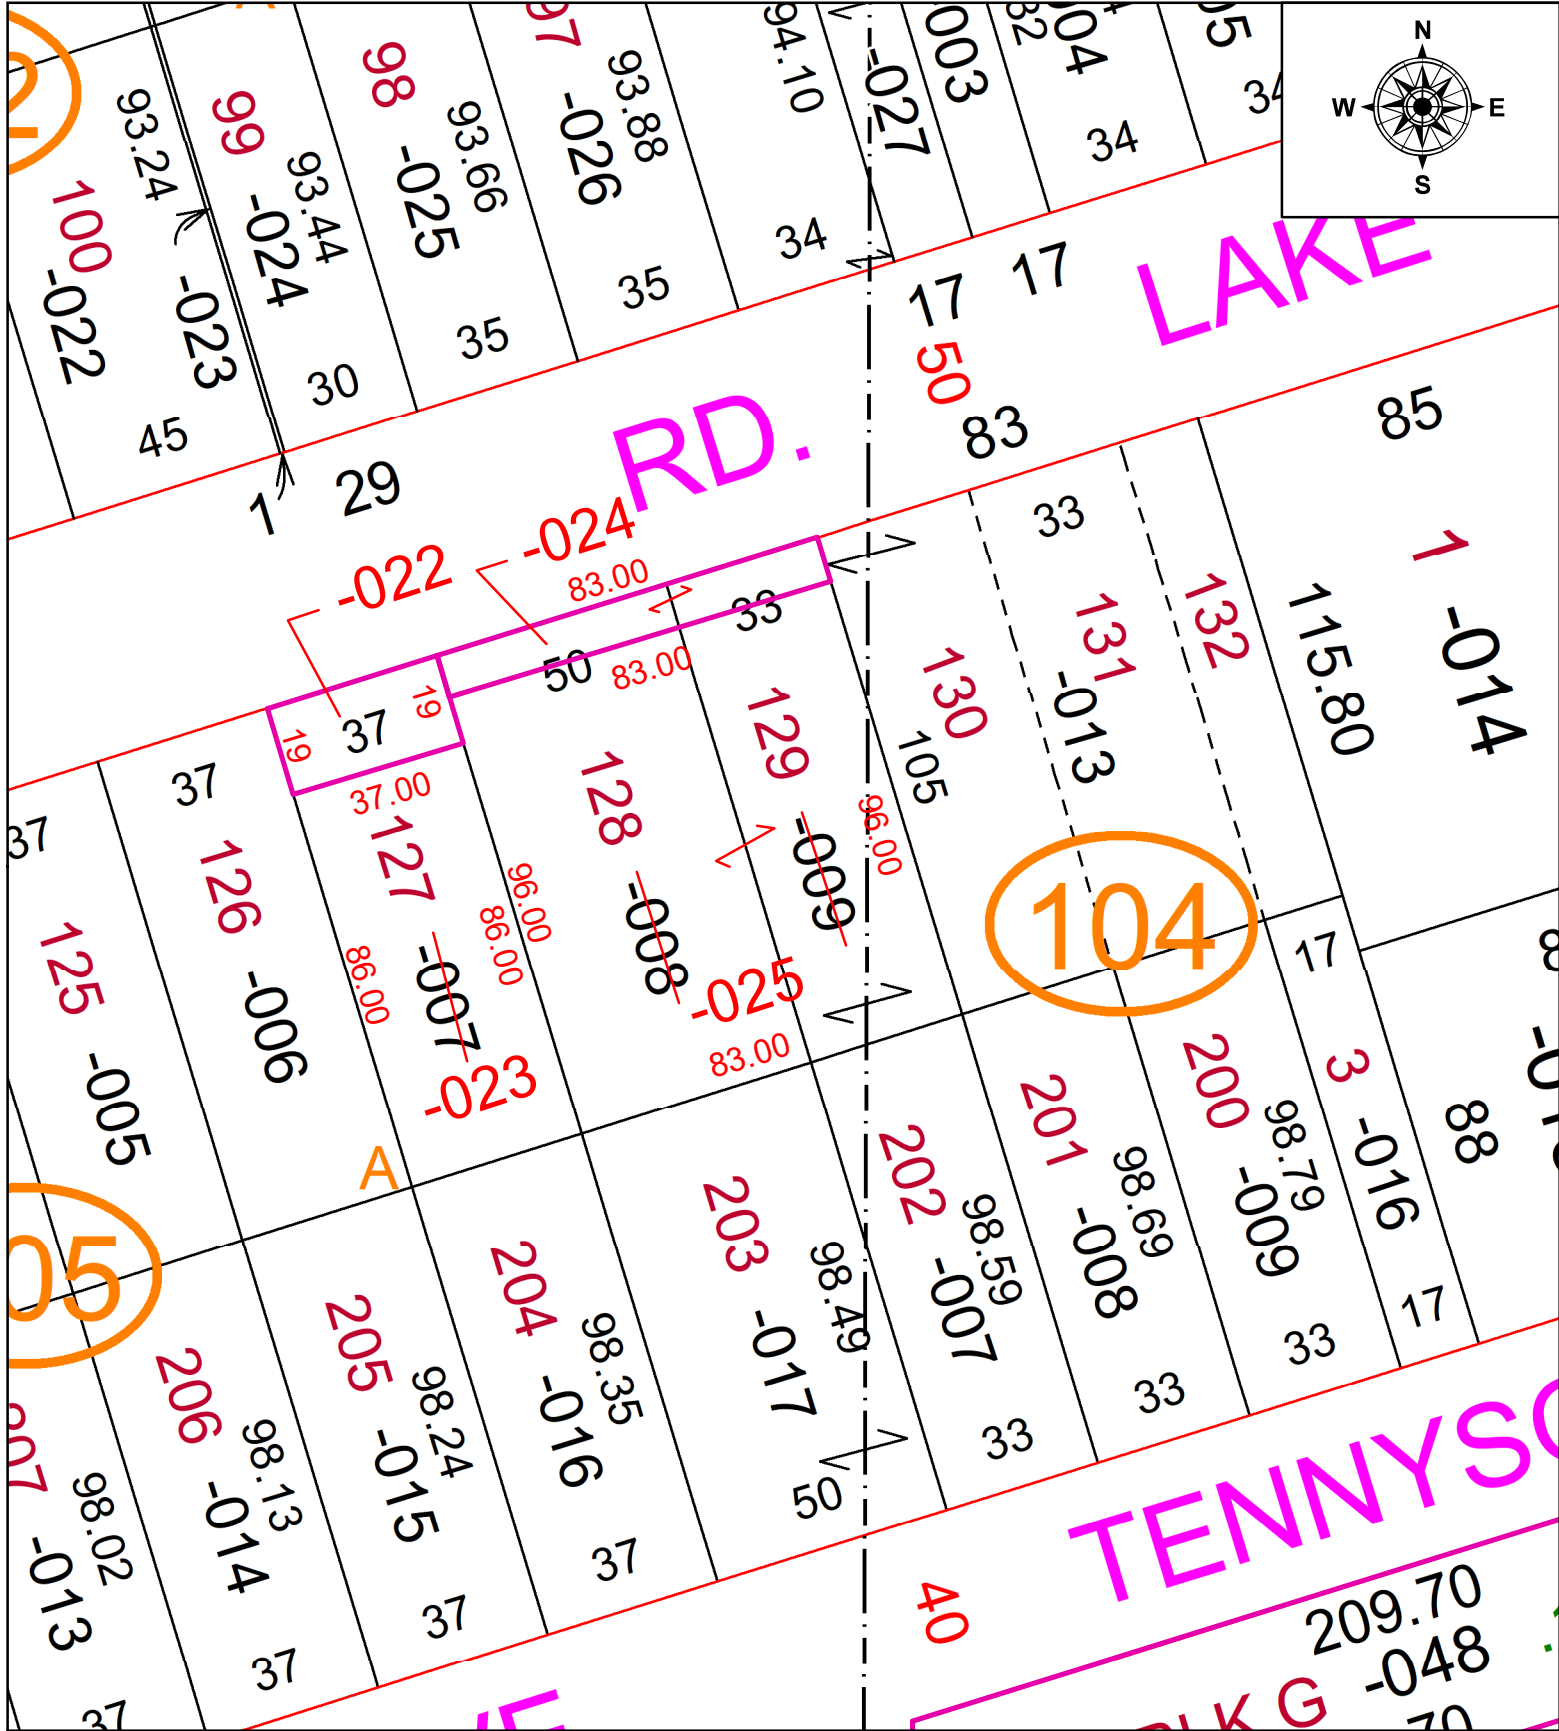

SPLITS/DEEDS PROCESSED
 LORAIN COUNTY TAX MAP DEPARTMENT
 226 MIDDLE AVE. ELYRIA, OH

SURVEYED BY: AMY KELLY
 CLOSURE: 1: INF
 MAP PAGE(S): 03-00-040
 APPROVED BY: TJS DATE: 9/26/2024
 SCALE: 1" = 40' PRIOR INSTRUMENT: 2019-0721595