
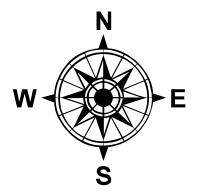


PARENT PARCEL: 03-00-039-104-013

CHILD PARCEL: 03-00-039-104-017 & -018

STARTING POINT: MAG. NAIL SET, CL OF KENILWORTH AVE. & CL OF LAKE RD.

24-00798

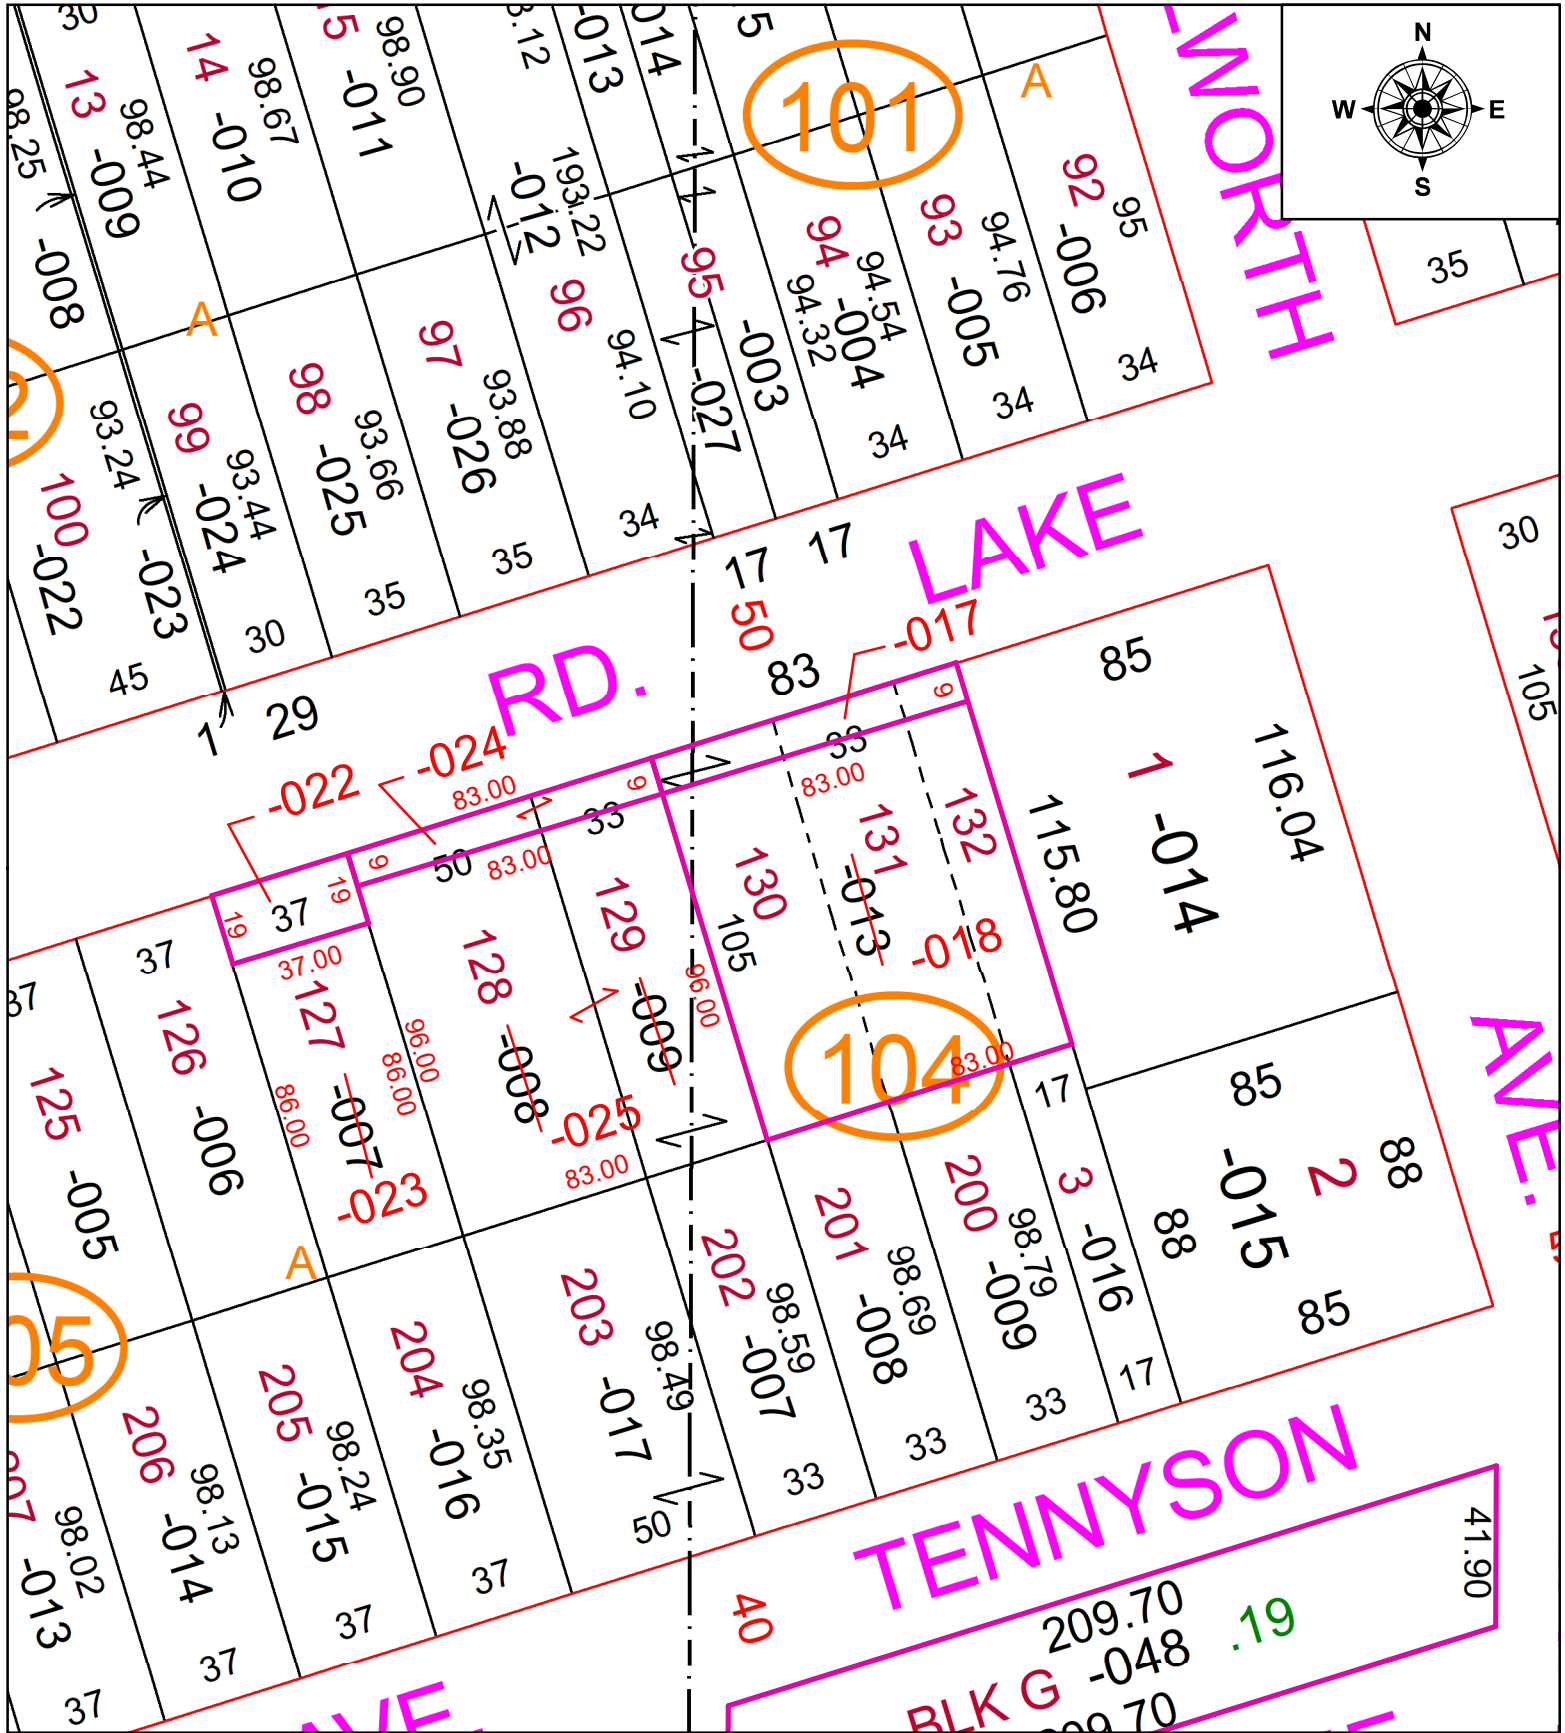

SPLITS/DEEDS PROCESSED

LORAIN COUNTY TAX MAP DEPARTMENT
226 MIDDLE AVE. ELYRIA, OH

SURVEYED BY:	AMY KELLY
CLOSURE:	1: INF
MAP PAGE(S):	3-00-039
APPROVED BY:	TJS DATE: 9/30/2024
SCALE:	1" = 50' PRIOR INSTRUMENT: 2024-0001095