
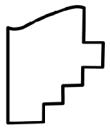


PARENT PARCEL: 03-00-039-104-014

CHILD PARCEL: 03-00-039-104-019 & -020

STARTING POINT: MAG. NAIL SET, CL OF KENILWORTH AVE. & CL OF LAKE RD.

24-00799

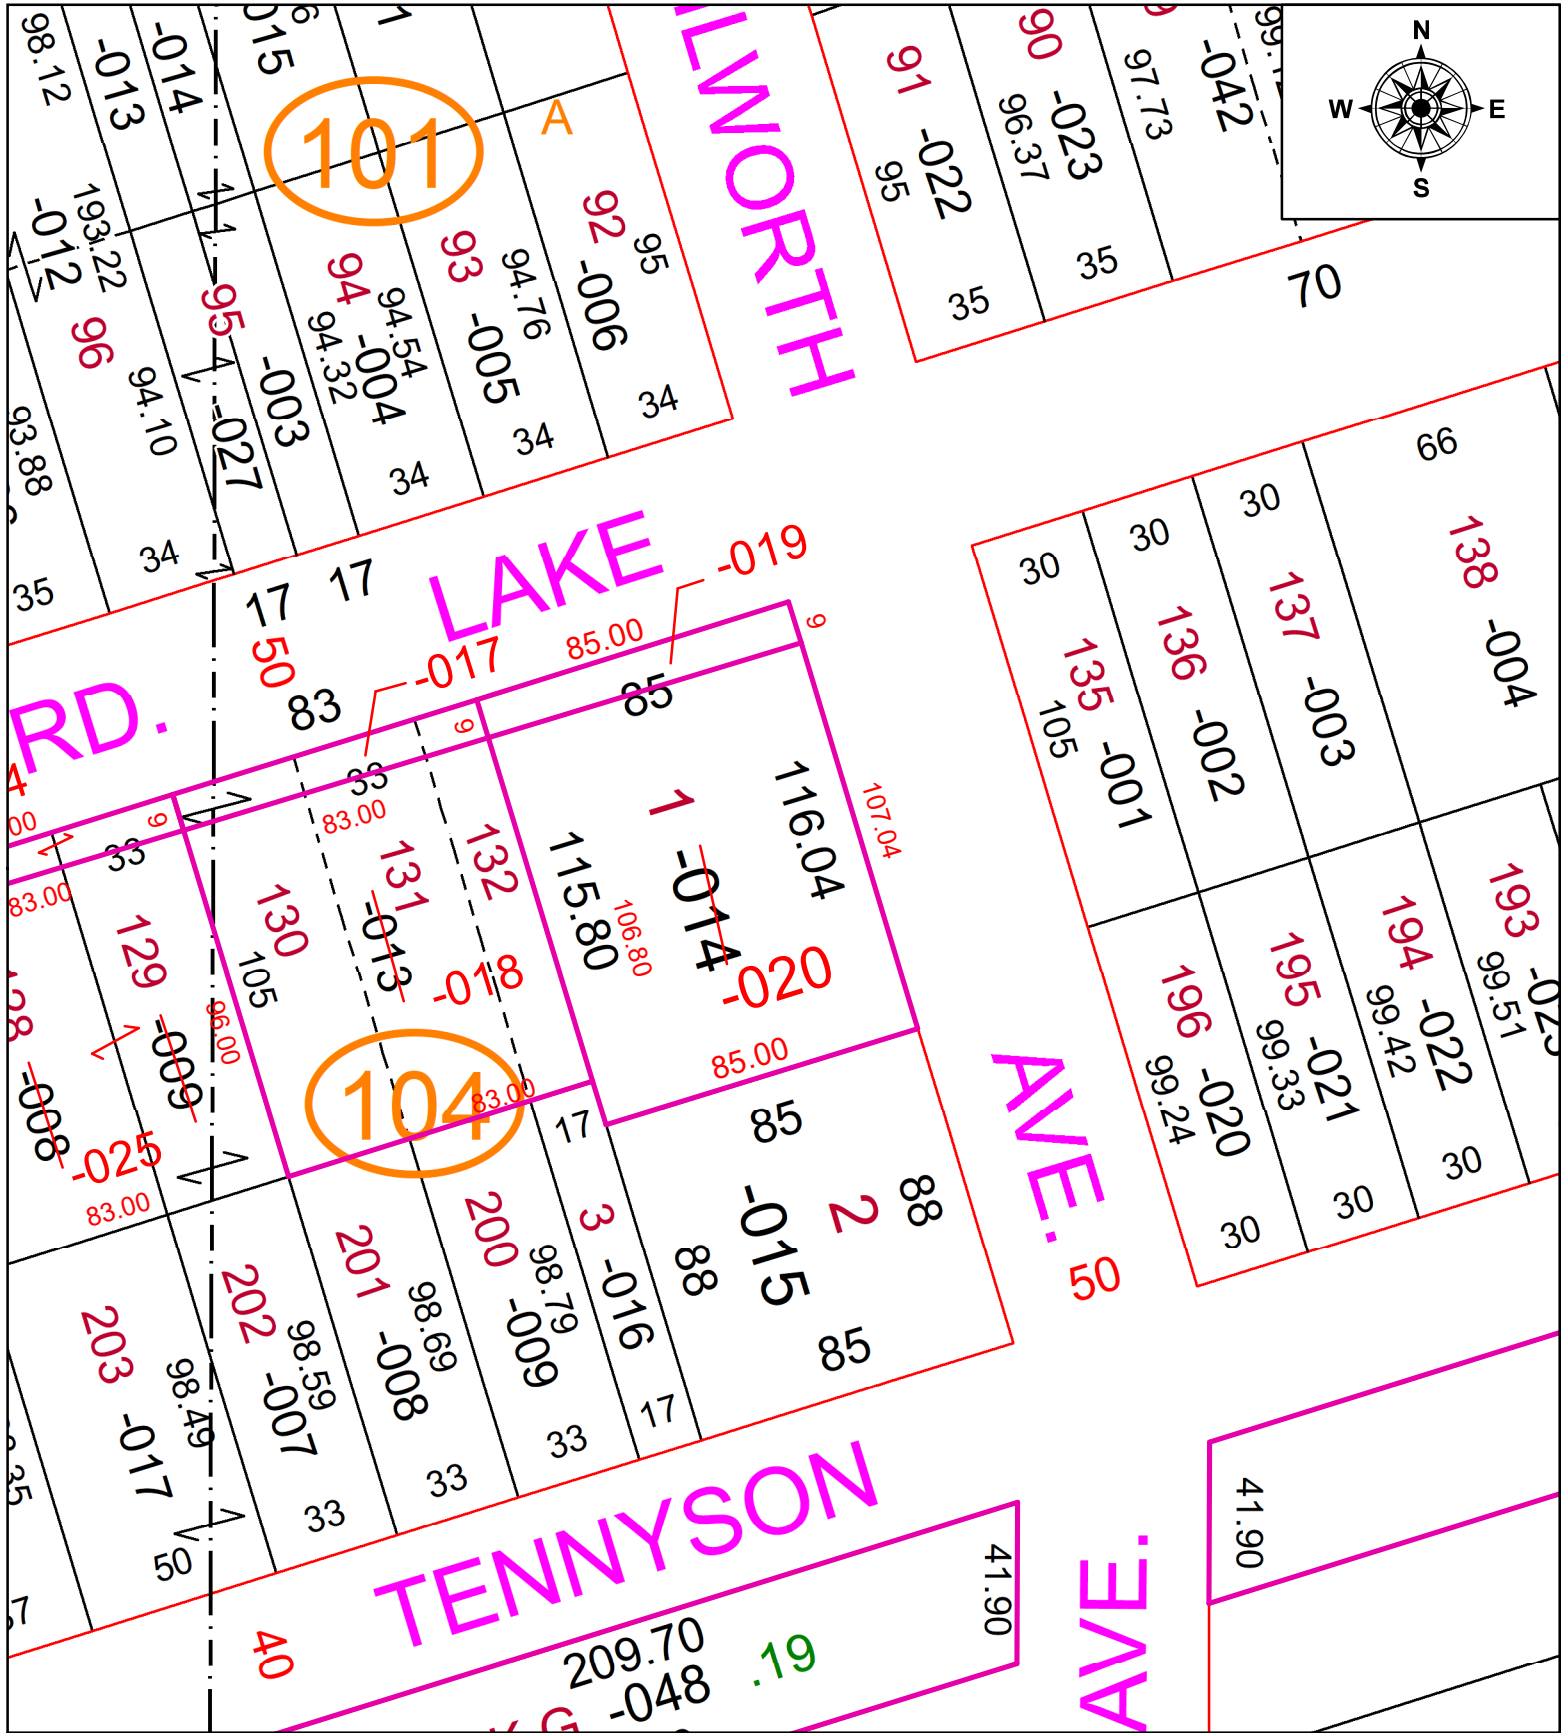

**SPLITS/DEEDS PROCESSED**  
 LORAIN COUNTY TAX MAP DEPARTMENT  
 226 MIDDLE AVE. ELYRIA, OH

SURVEYED BY: AMY KELLY  
 CLOSURE: 1: INF  
 MAP PAGE(S): 3-00-039  
 APPROVED BY: TJS DATE: 10/1/2024  
 SCALE: 1" = 50' PRIOR INSTRUMENT: 2014-0497906