
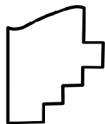
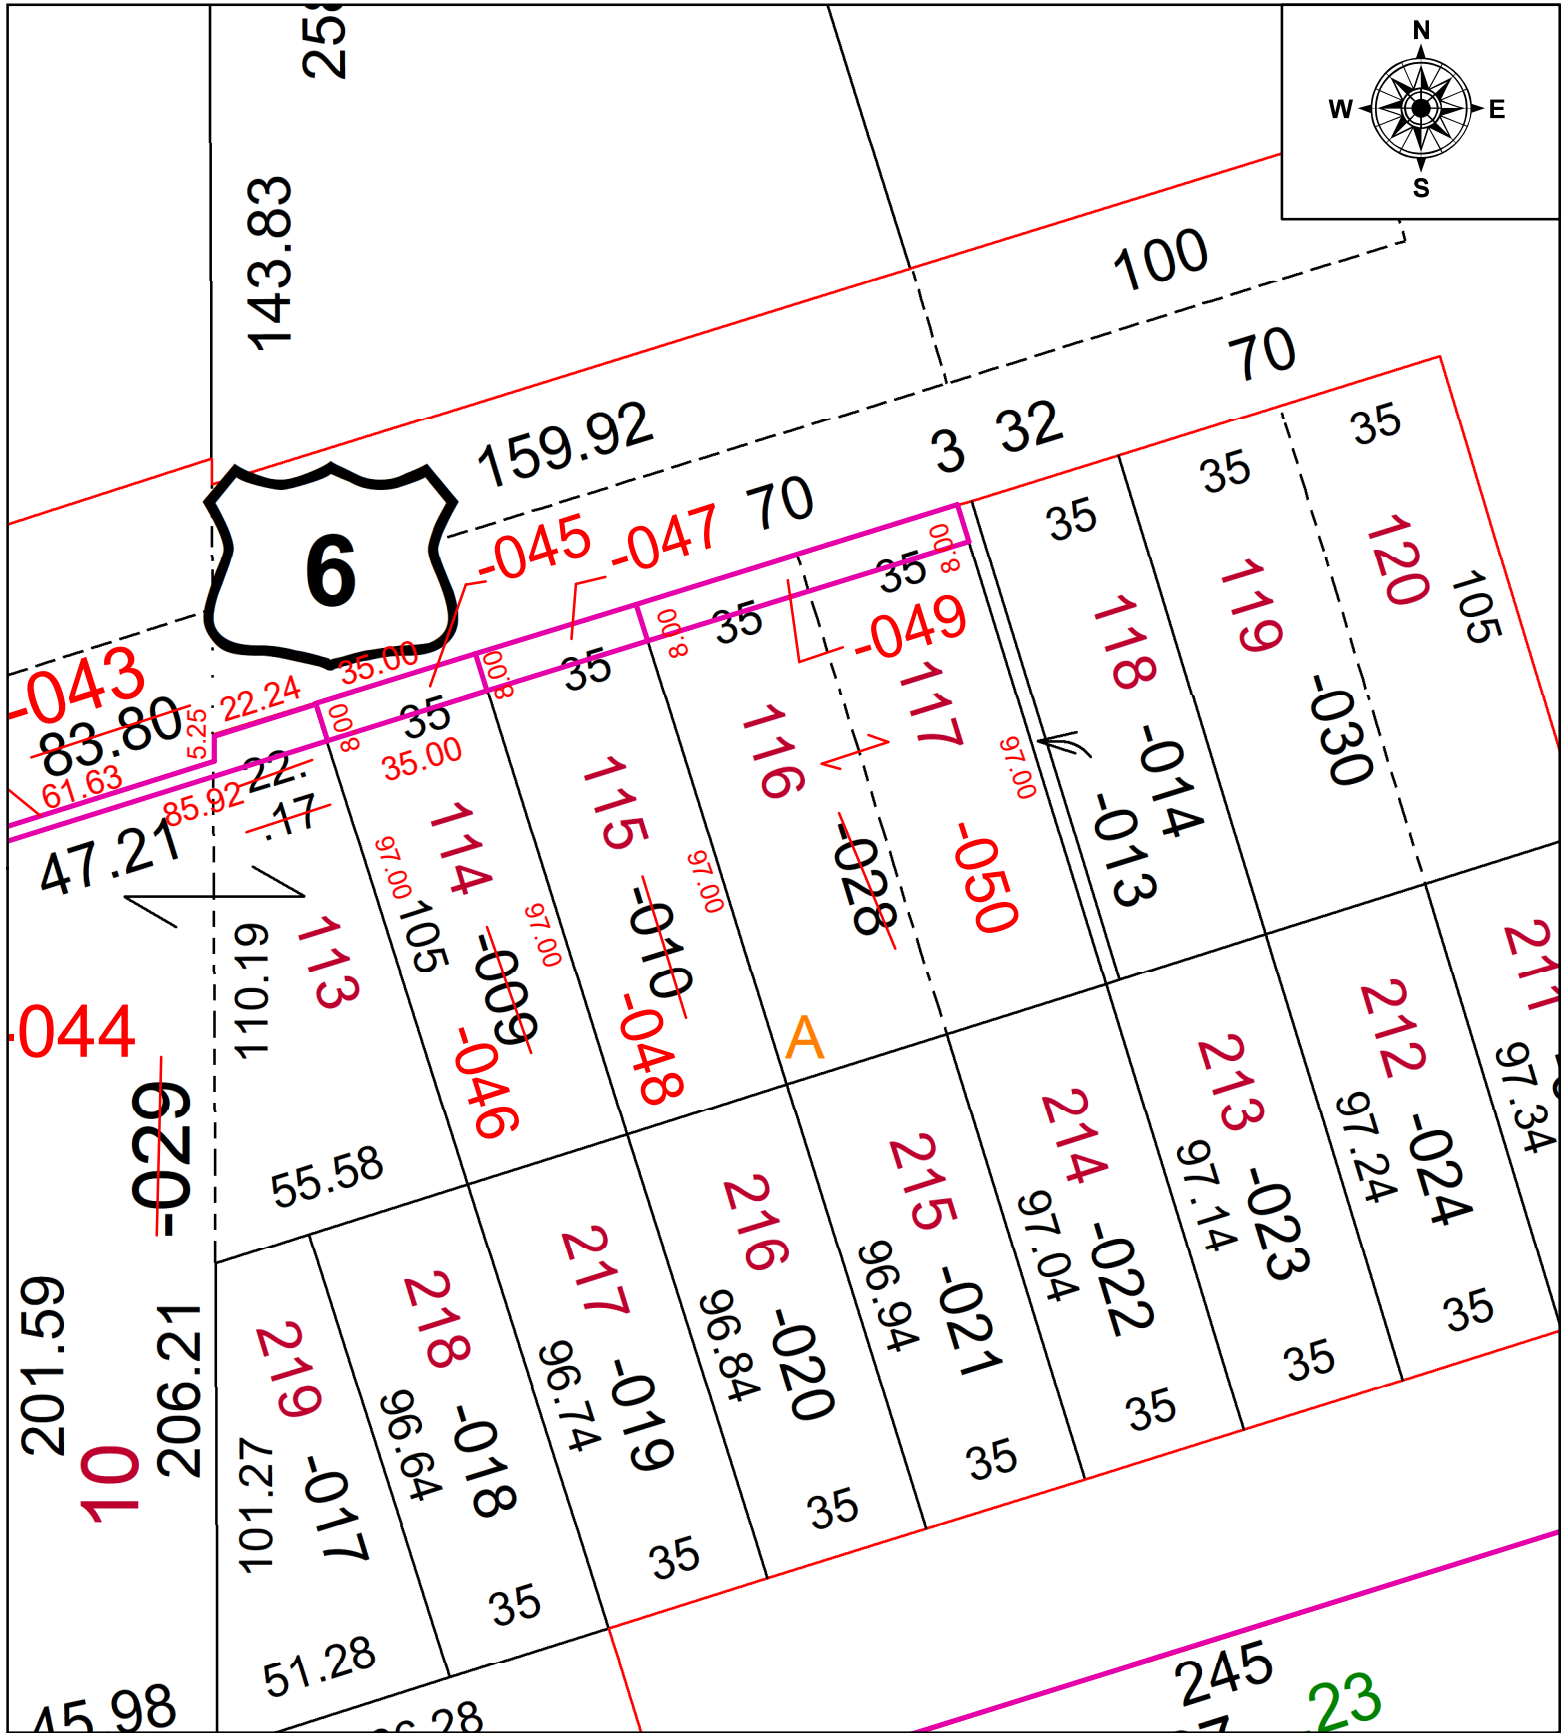


PARENT PARCEL: 03-00-040-104-010 & -028

CHILD PARCEL: 03-00-040-104-047 thru -050 4-WD1 & 4WD-2 LOR-US-6-13.69

STARTING POINT: MAG. NAIL, CL OF LAKE RD. & CL OF GRANTWOOD AVE.

24-00805

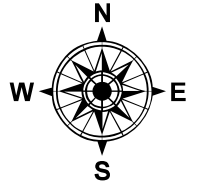

**SPLITS/DEEDS PROCESSED**  
LORAIN COUNTY TAX MAP DEPARTMENT  
226 MIDDLE AVE. ELYRIA, OH

SURVEYED BY: AMY KELLY  
CLOSURE: 1: INF  
MAP PAGE(S): 03-00-040  
APPROVED BY: TJS DATE: 11/4/2024  
SCALE: 1" = 40' PRIOR INSTRUMENT: 2012-0433628