


RASTER

PARENT PARCEL: 05-00-062-101-085

CHILD PARCEL:

STARTING POINT: N/A

NO. 00517-A

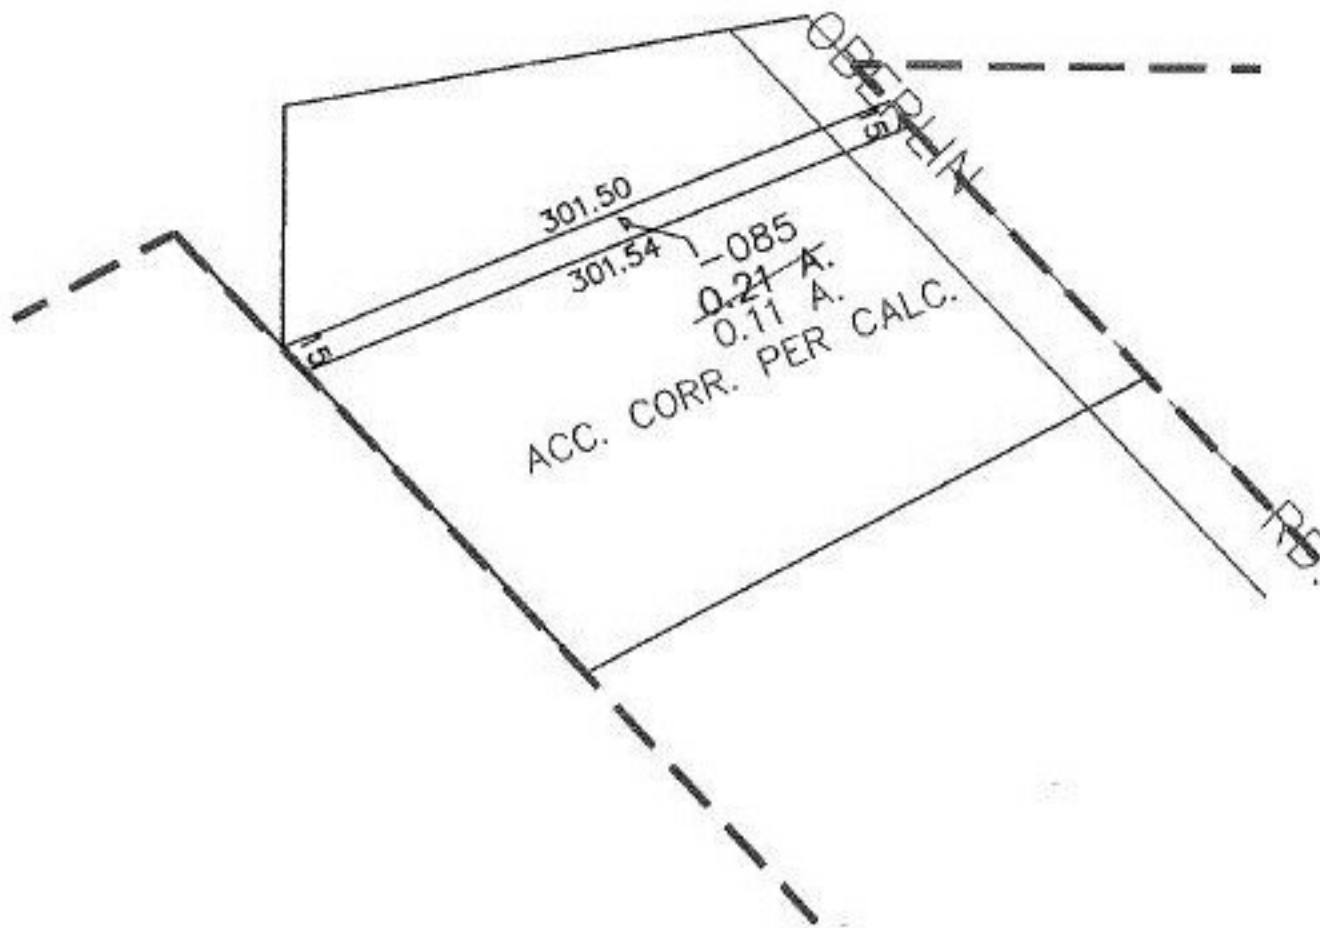

SPLITS/DEEDS PROCESSED

LORAIN COUNTY TAX MAP DEPARTMENT
226 MIDDLE AVE. ELYRIA, OHIO

SURVEYED BY: N/A

CLOSURE: N/A

MAP PAGE(S): 5-00-062-A

APPROVED BY: RRM DATE: 3-5-01

SCALE: 1" = 100' PRIOR INSTRUMENT: DV 875/145