

RASTER

PARENT PARCEL: 18-00-027-104-002

CHILD PARCEL: XXXXXXXXXXXX

STARTING POINT: SOUTHERLY R.O.W. OF HERRICK AVE. & EASTERLY R.O.W. OF BENNETT ST.

NO. 00525-X

FR. & DEPTH CORR.

18-00-027-104-002

~~79.65 X 165~~


79.56 X 165

CORR. PER DEED
20010734819



HERRICK AVE.

BENNETT ST.

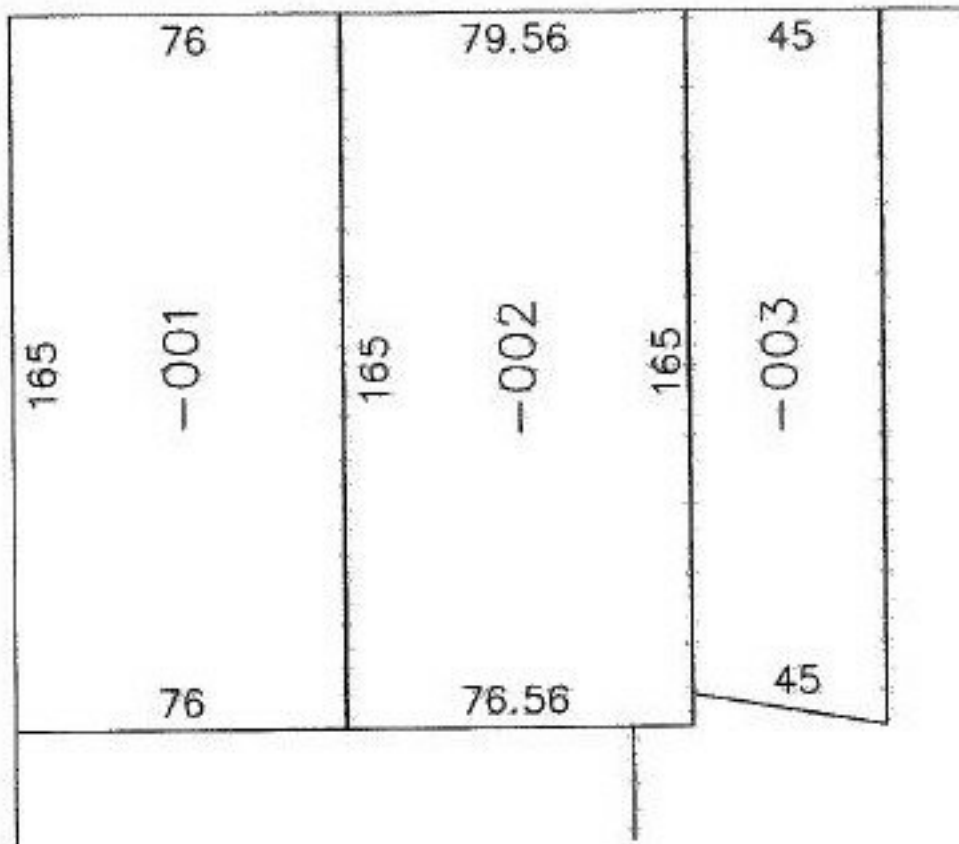

SPLITS/DEEDS PROCESSED
LORAIN COUNTY TAX MAP DEPARTMENT
226 MIDDLE AVE. ELYRIA, OHIO

SURVEYED BY: NONE
 CLOSURE: CAN'T RUN
 MAP PAGE(S): 18-00-027-A
 APPROVED BY: IJS DATE: 03/12/01
 SCALE: 1" = 50' PRIOR INSTRUMENT: 20010734819