


RASTER

PARENT PARCEL: 15-00-031-000-004

CHILD PARCEL:

STARTING POINT: AT A MON. BOX AT THE INTERSECTION OF BIGGS RD. AND INDIAN HOLLOW RD.

NO. 00537-A

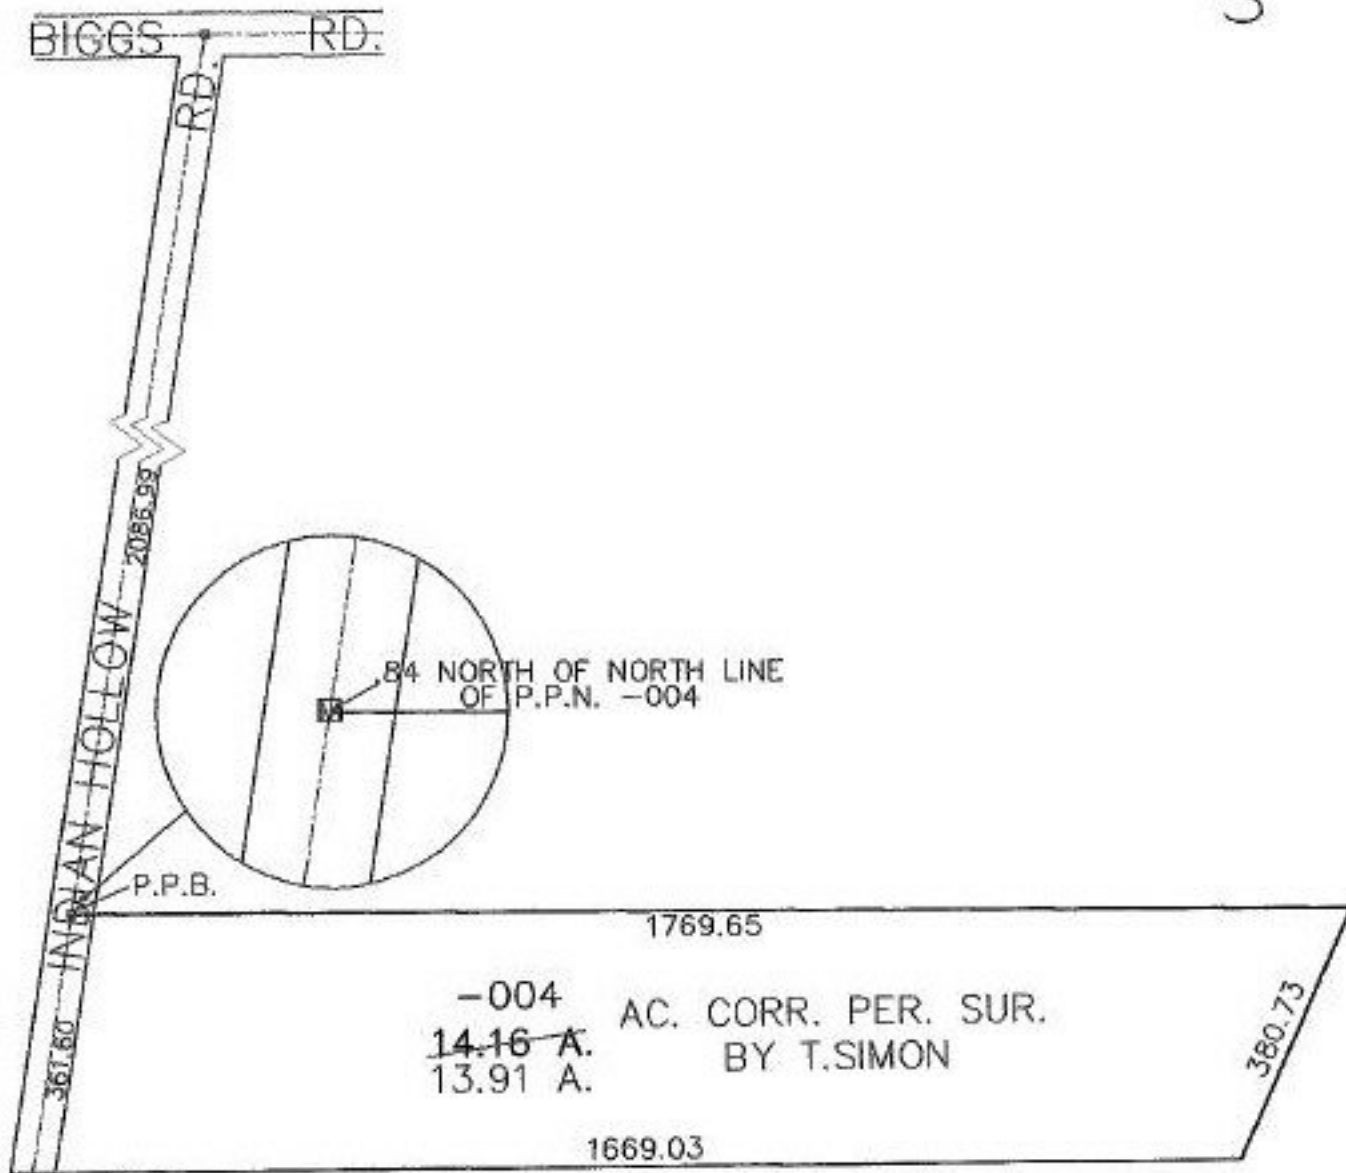

SURVEYED BY: T.SIMON
 CLOSURE: N/A
 MAP PAGE(S): 15-00-031-A.15-D
 APPROVED BY: RBM DATE: 3-20-01
 SCALE: 1" = 300' PRIOR INSTRUMENT: DV XXXX/XXX



SPLITS/DEEDS PROCESSED
 LORAIN COUNTY TAX MAP DEPARTMENT
 226 MIDDLE AVE. ELYRIA, OHIO