

PLASTER

PARENT PARCEL: 01-00-010-000-023

CHILD PARCEL: 01-00-010-000-024



STARTING POINT: S.E. CORNER OF DEER TRAIL LANE

NO. 00544-C

# CORRECTION - ADD TO DUPLICATE

CORRECTION 01-00-010-000-023  
~~12.34 A.~~  
 10.94 A.

ADD TO DUP. 01-00-010-000-024  
 1.50 A.

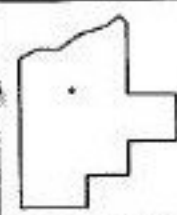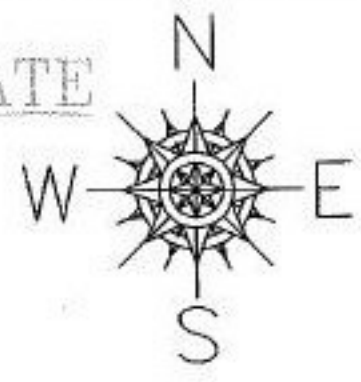

**SPLITS/DEEDS PROCESSED**  
 LORAIN COUNTY TAX MAP DEPARTMENT  
 226 MIDDLE AVE. ELYRIA, OHIO

SURVEYED BY: BRUCE L. ROBINSON  
 CLOSURE: 0.01 : 10,000  
 MAP PAGE(S): 1-D  
 APPROVED BY: TJS DATE: 4/9/01  
 SCALE: 1" = 300 PRIOR INSTRUMENT: 200000723868